

# LOAN DOCUMENT

PHOTOGRAPH THIS SHEET

DTIC ACCESSION NUMBER

LEVEL

(O)

INVENTORY

*Operations & Maintenance Manual*

DOCUMENT IDENTIFICATION

*OCT 97*

H  
A  
N  
D  
L  
E  
  
W  
I  
T  
H  
  
C  
A  
R  
E

**DISTRIBUTION STATEMENT A**  
Approved for Public Release  
Distribution Unlimited

DISTRIBUTION STATEMENT

ACCESSION TYPE	NTIS	GRAM	<input checked="" type="checkbox"/>
	DTIC	TRAC	<input type="checkbox"/>
UNANNOUNCED			<input type="checkbox"/>
JUSTIFICATION			
BY			
DISTRIBUTION/			
AVAILABILITY CODES			
DISTRIBUTION	AVAILABILITY AND/OR SPECIAL		
A-1			

DISTRIBUTION STAMP

DATE ACCESSED

DATE RETURNED

20001214 097

DATE RECEIVED IN DTIC

REGISTERED OR CERTIFIED NUMBER

PHOTOGRAPH THIS SHEET AND RETURN TO DTIC-FDAC

---

# **OPERATIONS AND MAINTENANCE MANUAL FOR EXPANDED BIOVENTING SYSTEM**

**SITE SS-41**

**FORMER BUILDING NO. 93 (FUEL PUMPING STATION NO. 3)  
CHARLESTON AIR FORCE BASE  
CHARLESTON, SOUTH CAROLINA**

---

**PREPARED FOR:**

**AIR FORCE CENTER FOR ENVIRONMENTAL EXCELLENCE  
TECHNOLOGY TRANSFER DIVISION  
BROOKS AIR FORCE BASE  
SAN ANTONIO, TEXAS**

**AND**

**437 CES/CEV  
CHARLESTON AIR FORCE BASE  
CHARLESTON, SOUTH CAROLINA**

**OCTOBER 1997**

*AQM01-03-0527*

**DEFENSE TECHNICAL INFORMATION CENTER  
REQUEST FOR SCIENTIFIC AND TECHNICAL REPORTS**

Title

*AFCEE Collection*

## 1. Report Availability (Please check one box)

- This report is available. Complete sections 2a - 2f.  
 This report is not available. Complete section 3.

## 2a. Number of Copies Forwarded

*1 each*

## 2b. Forwarding Date

*July/2000*

## 2c. Distribution Statement (Please check ONE box)

- DISTRIBUTION STATEMENT A: Approved for public release. Distribution is unlimited.  
 DISTRIBUTION STATEMENT B: Distribution authorized to U.S. Government Agencies only.  
 DISTRIBUTION STATEMENT C: Distribution authorized to U.S. Government Agencies and their contractors.  
 DISTRIBUTION STATEMENT D: Distribution authorized to U.S. Department of Defense (DoD) and U.S. DoD contractors only.  
 DISTRIBUTION STATEMENT E: Distribution authorized to U.S. Department of Defense (DoD) components only.  
 DISTRIBUTION STATEMENT F: Further dissemination only as directed by the controlling DoD office indicated below or by higher authority.  
 DISTRIBUTION STATEMENT X: Distribution authorized to U.S. Government agencies and private individuals or enterprises eligible to obtain export-controlled technical data in accordance with DoD Directive 5230.26, Withholding of Unclassified Technical Data from Public Disclosure, 6 Nov 84.

## 2d. Reason For the Above Distribution Statement (in accordance with DoD Directive 5230.24)

## 2e. Controlling Office

*HQ AFCEE*

## 2f. Date of Distribution Statement Determination

*15 Nov 2000*

## 3. This report is NOT forwarded for the following reasons. (Please check appropriate box)

- It was previously forwarded to DTIC on \_\_\_\_\_ (date) and the AD number is \_\_\_\_\_  
 It will be published at a later date. Enter approximate date if known.  
 In accordance with the provisions of DoD Directive 3200.12, the requested document is not supplied because:  
\_\_\_\_\_

Print or Type Name

*Laura Peña*  
 Telephone  
 210-536-1431

Signature

*Laura Peña*

(For DTIC Use Only)

AQ Number

*M01-03-0527*

## TABLE OF CONTENTS

	<u>Page</u>
<b>SECTION 1 - INTRODUCTION .....</b>	<b>1-1</b>
<b>SECTION 2 - SYSTEM DESCRIPTION.....</b>	<b>2-1</b>
2.1    Blower System .....	2-1
2.2    Monitoring and Flow Control Equipment .....	2-1
2.2.1    Monitoring Gauges .....	2-1
2.2.2    Flow Control Equipment .....	2-2
<b>SECTION 3 - SYSTEM MAINTENANCE .....</b>	<b>3-1</b>
3.1    Blower/Motor.....	3-1
3.2    Air Filter.....	3-1
3.3    Maintenance Schedule .....	3-1
3.4    Major Repairs.....	3-2
<b>SECTION 4 - SYSTEM MONITORING .....</b>	<b>4-1</b>
4.1    Blower Performance Monitoring .....	4-1
4.1.1    Vacuum/Pressure .....	4-1
4.1.2    Temperature .....	4-1
4.2    Monitoring Schedule.....	4-1
4.3    Reporting Monitoring Results .....	4-1
<b>APPENDIX A Record Drawings</b>	
<b>APPENDIX B Regenerative Blower Information</b>	
<b>APPENDIX C Data Collection Sheets</b>	

## SECTION 1

### INTRODUCTION

This Operations and Maintenance (O&M) Manual has been created as a guide for monitoring and maintaining the performance of the expanded bioventing blower systems and vent well plumbing at Site SS-41 (Former Building No. 93 Fuel Pumping Station 3), Charleston AFB, South Carolina. Record drawings of the expanded bioventing system installed at Site SS-41 are provided in Appendix A.

Bioventing is the forced injection of fresh air, or withdrawal of soil gas, to enhance the supply of oxygen in subsurface soils to promote *in situ* bioremediation of organic fuel compounds. A blower system is used to inject air into the soil, thereby supplying fresh atmospheric air (containing approximately 20.8 percent oxygen) to fuel-contaminated soils. Once oxygen is provided to the subsurface, existing soil bacteria aerobically metabolize the fuel residuals. Aerobic biodegradation is much more efficient than anaerobic biodegradation, which occurs in oxygen-depleted soils.

A pilot-scale bioventing system was installed and operated by Parsons ES at the site from July 1994 through August 1995. The pilot scale system consisted of two vertical vent wells (VWs) and four multi-depth soil vapor monitoring points (MPs) installed on the west side of the former underground storage tank (UST) system. Pilot test monitoring results showed that a large portion of the site was not being affected by the air injection, especially areas north and east of the pilot-scale system.

Parsons ES designed and installed a full-scale bioventing system to address the soil oxygen deficiency in areas with remaining soil contamination that were not treated by the pilot-scale system. The full-scale air injection bioventing system consists of two air injection blowers, ten new vertical VWs, ten new soil gas MPs, and associated piping. Existing pilot system VWs and MPs were incorporated into the full-scale system. The new system was installed at the site from February, 1997 through May, 1997. The air injection rates of the full-scale bioventing system were optimized at each vent well to assure adequate aeration of contaminated soils to promote aerobic biodegradation. Soil gas monitoring performed in May and June 1997, after several weeks of operating the new VWs, indicates the majority of the area designated for bioventing treatment is receiving sufficient oxygen. Most of these subsurface soils are receiving oxygen concentrations greater 15%, although several locations have shown less significant increases in soil gas oxygen content.

Charleston AFB personnel are responsible for routine monitoring of the bioventing system. Parsons ES has trained Charleston AFB personnel on the maintenance requirements of this plan. If significant problems are encountered with the operation of the system, Parsons ES should be notified so repairs can be made. Under the Extended Bioventing Project Option 1, Parsons ES is responsible for system repair for a 1-year period after system startup. Parsons ES will retain responsibility for system repair until May 1998. Should the bioventing system cease to operate or develop a significant problem, please call the Parsons ES Site Manager, Mr. Grant Watkins, at (919) 677-0080, or Mr. John Ratz, at (303) 831-8100. If the system ceases to operate, first have a base electrician verify that adequate power is being supplied to the bioventing system blower motor prior to notifying Parsons ES.

## SECTION 2

### SYSTEM DESCRIPTION

#### **2.1 BLOWER SYSTEM**

Two Gast® R5125Q blowers, each powered by a 2-horsepower direct drive motor, were installed at Site SS-41 on April 24-25, 1997. Each blower was installed in a separate enclosure, with both enclosures located on a single concrete pad. The R5125Q blower is rated as having a maximum flow rate of 160 standard cubic feet per minute (scfm) at open flow and a maximum pressure rating of 55 inches of water. As installed, the blower on the south side of the concrete pad (blower #1) provides air to five vent wells (VW-2 through VW-6) located on the south and east portions of the site. The blower on the north side of the concrete pad (blower #2) supplies air to six vent wells (VW-7 through VW-12), located primarily on the north and west sides of the site.

During initial system startup on May 9, 1997, blower #1 was producing an estimated flow rate of 15 actual cubic feet per minute (acf m) at a pressure of 34 inches of water. Blower #2 was started at a flow rate of 16.5 acf m at a pressure of 34 inches of water. The air injection flow rates were increased at both blowers on May 21-22, 1997 after soil gas monitoring indicated that some areas were not receiving adequate concentrations of soil gas oxygen. Final blower readings representative of longer term system performance were obtained on June 10, 1997. On that date, blower #1 (wells VW-2 through VW-6) was injecting air at 56 acf m at 29 inches of water pressure. Air flow rates to the individual wells ranged from a minimum of 1.9 acf m at VW-3 to a maximum of 22.1 acf m at VW-5. Blower #2 (wells VW-7 through VW-12) was operating at 43 acf m total air flow at 51 inches of pressure. Air flow rates to individual wells connected to the blower #2 ranged from 1.8 acf m at VW-9 to 17.8 acf m at combined wells VW-8/VW-12. Flow was optimized to each VW based on 1) the degree of hydrocarbon contamination present within soils in the vicinity of each VW, 2) the amount of oxygen measured at surrounding MPs following four weeks of operation, and 3) limitations to air injection due to variations in site physical characteristics. Generally, higher flow rates at lower pressures are observed in soils on the south and east part of the site. Air injection flow rates are lower and injection pressures generally are higher on the north end of the site.

The blower systems include an inlet air filter to remove any particulates which are entrained in the inlet air stream and several valves and monitoring gauges which are described in Section 2.2. A schematic of the expanded blower systems installed at Site SS-41 is shown in Appendix A. Corresponding blower performance curves and relevant service information are provided in Appendix B. Blower system data collection sheets for use by base personnel are provided in Appendix C.

#### **2.2 MONITORING AND FLOW CONTROL EQUIPMENT**

##### **2.2.1 Monitoring Gauges**

The bioventing system is equipped with vacuum, pressure, and temperature gauges, and air velocity measurement ports. Gauges have been installed on the air injection system at the

following locations: a vacuum gauge in the inlet piping and pressure and temperature gauges in the outlet piping on each blower.

## **2.2.2 Flow Control Equipment**

Manual and automatic flow control valves (FCVs) have been installed on the bioventing blower systems. Manual FCVs have been installed in the piping leading to each VW to enable the flow rate to each VW to be adjusted individually. An automatic FCV, or pressure relief valve (PRV), is used to protect each blower system from burning out if pressures rise due to pipe blockage. The PRV is set to bleed off flow at a preset pressure and thus prevent blower outlet pressure from ever exceeding the rated pressure.

An additional FCV (bleed valve) has been installed to control the total air flow out of each blower by releasing excess air flow to the atmosphere. The FCVs have been set by Parsons ES personnel to deliver a calculated amount of air to each VW and should not be adjusted unless directed to do so by Parsons ES personnel.

Each blower systems has also been equipped with air flow measurement ports. These ports consist of brass bushings installed in the outlet piping leading to each VW. These bushings, which should be plugged during system operation, allow the insertion of a thermal anemometer for the measurement of air velocity. These ports are used by Parsons ES for system optimization and should not be opened unless air flow measurements are being collected.

Although the blower systems installed at Site SS-41 are relatively maintenance free, periodic system maintenance is required for proper operation and long life. Recommended maintenance procedures and schedule are described in detail in the instruction manuals included in Appendix B and briefly summarized in this section.

Filter inspection must be performed with the system turned off. Do not change the flow control valve settings (valves have been pre-set for a specific flow rate) before re-starting the blower.

## SECTION 3

### SYSTEM MAINTENANCE

#### **3.1 BLOWER/MOTOR**

The blowers and their motors are relatively maintenance free and should not require any maintenance during the operational period. Both the blowers and motors have sealed bearings and do not require lubrication.

#### **3.2 AIR FILTER**

To avoid damage caused by passing solids through the blower, an air filter has been installed in-line before each blower. The paper filter element is accompanied by a polyurethane foam pre-filter. The filter should be checked weekly for the first 2 months of operation. A facility employee should determine the best schedule for filter replacement based on the first 2 months of system monitoring. The polyurethane pre-filters can be washed with lukewarm water and a mild detergent. Paper filter elements should never be washed, and should be disposed of and replaced as necessary. When the vacuum drop across the filter increases by approximately 5 inches of water compared to the vacuum when the filter was new, a dirty filter element should be suspected. Cleaning or replacement of the filter should then be performed. The initial vacuum when the filter element was new was 9 inches of water on Blower #1 (wells VW2-VW6) and 5 inches of water on Blower #2 (VW7-VW12). Therefore, the filters should be cleaned or replaced when the vacuum increases to 14 and 10 inches of water for each blower, respectively. Typical filter element replacement intervals range from 3 to 6 months.

To remove the filter, turn the system off by pushing the electrical disconnect switch (on the adjacent electrical utility pole) to the "off" position. Then, loosen the three clamps or the wing nut on the filter top, lift the metal top off the air filter, and lift the air filter element from the metal housing. Remove the polyurethane pre-filter (if applicable) and wash before replacing.

The filter element is manufactured by Solberg Manufacturing, Inc. in Itasca, Illinois. Their toll free telephone number is 1-800-451-0642. Additional filters can also be obtained through Parsons ES. The Parsons ES contacts are Mr. Grant Watkins, at (919) 677-0080, and Mr. John Ratz, at (303) 831-8100. The part number for the replacement filter element is 30P. Four spare air filter elements have been placed inside each blower enclosure.

#### **3.3 MAINTENANCE SCHEDULE**

The following maintenance schedule is recommended for the blower systems. During the initial few months of operation more frequent monitoring is recommended to ensure that any startup problems are quickly corrected. A daily drive-by inspection is recommended during the initial 2 weeks of operation to ensure that the blower system is still operating with no unusual sounds. Thereafter, monitoring inspections every 2 weeks are recommended (see Section 4). Preprinted data collection sheets have been provided to the facility. Extra data collection sheets for recording maintenance activities are provided in Appendix C.

<u>Maintenance Item</u>	<u>Maintenance Frequency</u>
Filter	Check once every 2 weeks, wash or replace as necessary (see Section 3.3). Inlet vacuums exceeding 14 inches of water (blower #1) or 10 inches of water (blower #2) indicates that the filters require cleaning or replacement.

### **3.4 MAJOR REPAIRS**

Regenerative blowers are very reliable when properly maintained. Occasionally, however, a motor or blower will develop a serious problem. If a blower system fails to start, and a qualified electrician verifies that power is available at the blower or starter, Parsons ES should be contacted to arrange for repairs. The Parsons ES contacts are Mr. Grant Watkins, at (919) 677-0080, and Mr. John Ratz, at (303) 831-8100. Parsons ES is responsible for major repairs during the first year of operation.

## **SECTION 4**

### **SYSTEM MONITORING**

#### **4.1 BLOWER PERFORMANCE MONITORING**

To monitor the blowers' performance, the vacuum, pressure, and temperature will be measured. These data should be recorded every 2 weeks on a data collection sheet (provided in Appendix C). All measurements should be taken at the same time while each system is running. Because the systems are noisy inside the enclosures, hearing protection should be worn at all times.

##### **4.1.1 Vacuum/Pressure**

With hearing protection in place, unlock and open the blower enclosure (the enclosure lids should be supported by the two metal pipes located inside each of the enclosures). Record all vacuum and pressure readings directly from the gauges (in inches of water) for each blower. Record the measurements on the data collection sheet.

##### **4.1.2 Temperature**

With hearing protection in place, open the blower enclosures and record the temperature readings directly from the gauges in degrees Fahrenheit ( $^{\circ}\text{F}$ ). Record the measurements on a data collection sheet (provided in Appendix C). The temperature change can be converted to degrees Celsius ( $^{\circ}\text{C}$ ) using the formula  $^{\circ}\text{C} = (^{\circ}\text{F} - 32) \times 5/9$ . Temperatures of the operating blower systems have varied from about 120-150  $^{\circ}\text{F}$  and will change slightly (decrease) once the enclosure lids are opened.

#### **4.2 MONITORING SCHEDULE**

The following monitoring schedule is recommended for these systems. During the initial month of operation, more frequent monitoring is recommended to ensure that any start up problems are quickly corrected. Data collection sheets have been provided to assist your data collection and are included in Appendix C.

<b><u>Monitoring Item</u></b>	<b><u>Monitoring Frequency</u></b>
Vacuum/Pressure	Once every 2 weeks.
Temperature	Once every 2 weeks.

#### **4.3 REPORTING MONITORING RESULTS**

System monitoring data sheets should be faxed to the Parsons ES Site Manager, Mr. Grant Watkins (919) 677-0080, once every 2 months. However, if a significant change in the system temperatures or pressures are noted (such as a significant drop or increase in pressure) please call Mr. Watkins immediately. A significant change in system temperature or pressure may be indicative of a problem with the air delivery system or blower.

**APPENDIX A**  
**RECORD DRAWINGS**


Date	Rdy	Date	By
Reg No	A	7/19/96	65X DESIGN
Approved	B	7/11/97	RECORD DRAWING
Revised			
Checked			
Drawn			
Designated R&F			
Job No.	726876-2822		

**RECORD DRAWINGS FOR  
EXPANDED BIOVENTING SYSTEM  
SITE SS-41  
CHARLESTON AIR FORCE BASE**

**PREPARED FOR  
AFCEE  
JULY 1997**

**DRAWING INDEX**

- |                   |   |
|-------------------|---|
| <b>DRAWING NO</b> | <b>TITLE SHEET AND SITE LAYOUT</b>              |
| G-0.1             | LEGEND AND STANDARD TRENCH DETAILS              |
| G-0.2             | VENT WELL AND MONITORING POINT STANDARD DETAILS |
| G-0.3             | BLOWER P & ID                                   |
| G-0.4             | BLOWER PIPING LAYOUT DETAIL                     |
| G-0.5             | BLOWER SHED FIELD INSTALLATION DETAIL AND       |
| G-0.6             | BLOWER SHED CONSTRUCTION DETAILS                |

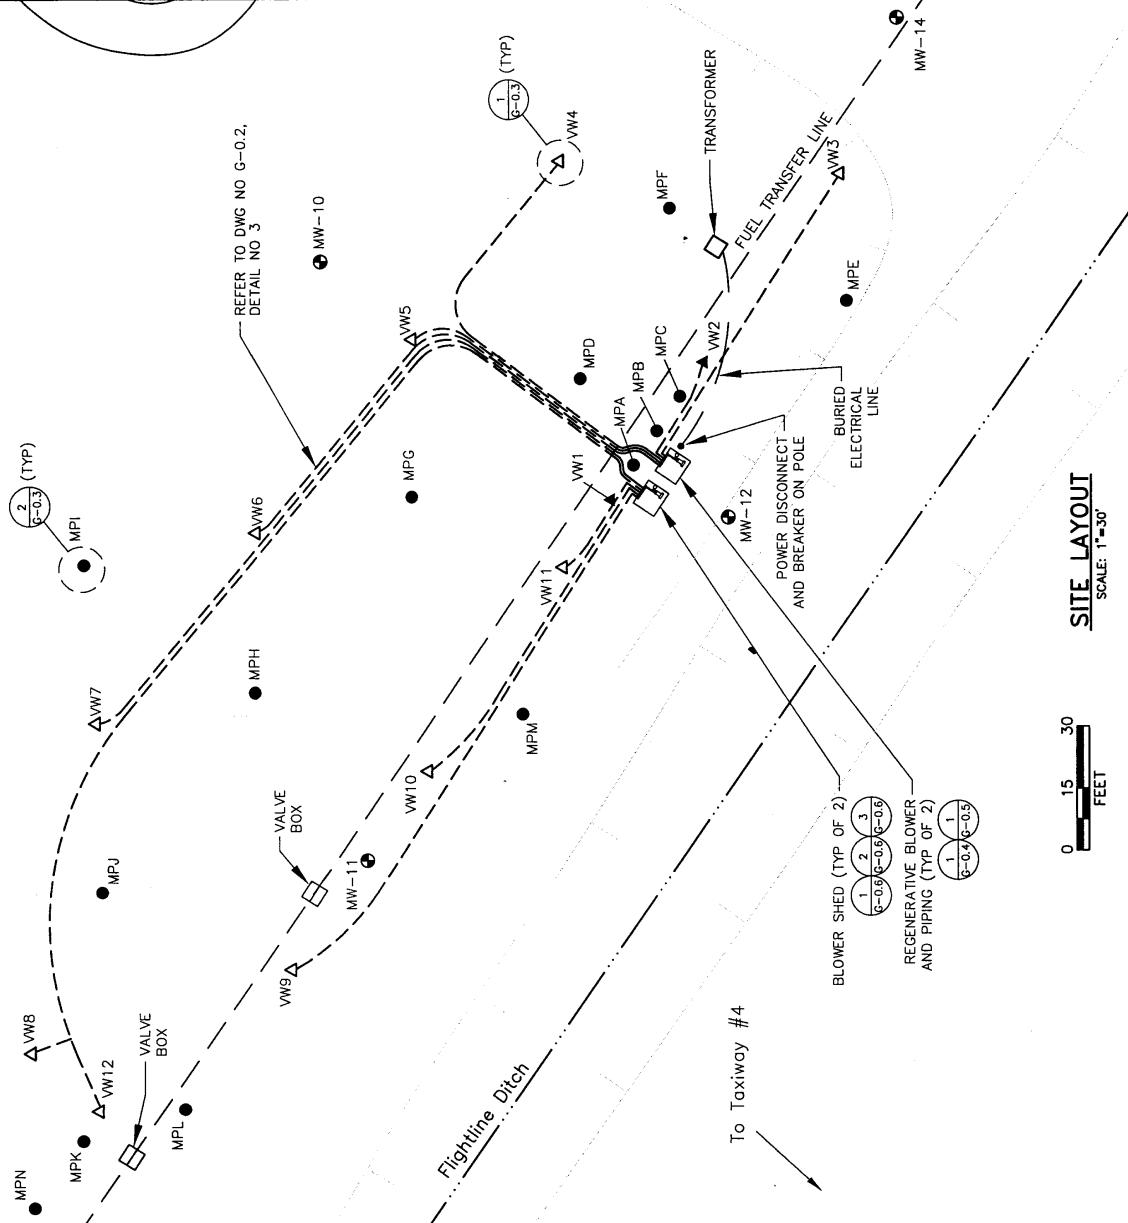

## ABBREVIATIONS

AU AIR INJECTION  
APPROX APPROXIMATE  
ASTM AMERICAN SOCIETY OF  
TESTING AND MATERIALS  
& AT

CBM CENTER BACK MOUNT  
CLR CLEAR  
DIAM DIAMETER

EXPLORATORY BORING  
ECC ECCENTRIC  
EW EACH WAY  
FLAT ON TOP

FEMALE PIPE THREAD  
FOOT FT

GALV GALVANIZED STEEL  
HOPE HOPE

HIGH DENSITY POLYETHYLENE  
FOR EXAMPLE  
LOWER MOUNT

MAXIMUM MAX

MINIMUM MIN

MONITORING POINT MP

MALE PIPE THREAD MPT

NATIONAL PIPE THREAD NPT

NOT TO SCALE NTS

ON CENTER OC

OUTSIDE DIAMETER OD

POLYVINYL CHLORIDE PVC

REDUCER PW

REDUCER REF

SCHEDULE SCH

SOCKET S

SLOTTED POLYVINYL CHLORIDE SPVC

STAINLESS STEEL ST. ST.

TYPICAL TIP

UNDERGROUND STORAGE TANK UST

VENT WELL VW

W/ W/

WELD NECK WN

WELDED WIRE FABRIC WWF

## SECTION DESIGNATION

### SECTION CUT

DRAWING NO. A-X  
SCALE: NTS

DRAWING NO. X-X  
SCALE: NTS

DRAWING NO. O-X  
SCALE: NTS

DRAWING NO. 1-X  
SCALE: NTS

DRAWING NO. 2-X  
SCALE: NTS

DRAWING NO. 3-X  
SCALE: NTS

## MATERIAL LEGEND

ASPHALT

BENTONITE

BENTONITE/CEMENT GROUT

BENTONITE PELLETS

BUILDING (EXISTING)

COMPACTED BACKFILL

COMPACTED BASE STONE

CONCRETE

PEA GRAVEL

SAND

UNDISTURBED SOIL

UNDISTURBED SOIL

## PIPE MATERIAL

CS CARBON STEEL

GS GALVANIZED STEEL

PPVC POLYVINYL CHLORIDE

SPVC SCREENED POLYVINYL CHLORIDE

## PIPE SERVICE

AU AIR INJECTION

BIV BIOVENTING

DR DRAIN

STANDARD TRENCH DETAILS  
LEGEND AND REV  
DRAWING NO. G-0.2 B

EXPANDED BIOCUTTING SYSTEM  
SITE SS-47  
CHARLESTON AIR FORCE BASE  
ENVIRONMENTAL EXCELLENCE  
PARSONS  
ENVIRONMENT SCIENCE, INC.  
Drafter, Code No. (303) 851-8100  
Designer, Code No. (303) 851-8100  
Checked MW  
Approved MW  
Revised No. 655 DESIGN  
Date 7/19/98  
Rev. B  
Drawing No. 726576-28242  
Job No. 726576-28242  
Description RECOMMENDED

STANDARD TRENCH DETAILS  
LEGEND AND REV  
DRAWING NO. G-0.2 B

ASPHALT  
REPLACEMENT DETAIL  
2  
SCALE: NTS

ASPHALT PLACE IN  
2-3" THICKNESS VARIOUS SURFACE (THICKNESS VARIES)  
EXISTING SURFACE (THICKNESS VARIES)  
BITUMINOUS TACK COAT ALL DOSES (TP)  
NEW CONCRETE TO MATCH EXISTING SURFACE  
NEW CONCRETE  
EXISTING SURFACE  
PEA GRAVEL  
4" (MIN)

ASPHALT  
REPLACEMENT DETAIL  
1  
SCALE: NTS

ASPHALT  
REPLACEMENT DETAIL  
1  
SCALE: NTS

6" x 6" WWF  
SACUT EAST CONCRETE  
BOND NEW CONCRETE TO  
EXIST CONCRETE  
EXISTING CONCRETE  
NEW CONCRETE TO  
MATCH EXISTING  
SURFACE  
PEA GRAVEL  
4" (MIN)

ASPHALT  
REPLACEMENT DETAIL  
2  
SCALE: NTS

6" x 6" WWF  
SACUT EAST CONCRETE  
BOND NEW CONCRETE TO  
EXIST CONCRETE  
EXISTING CONCRETE  
NEW CONCRETE TO  
MATCH EXISTING  
SURFACE  
PEA GRAVEL  
4" (MIN)

GRASS COVER  
REPLACEMENT DETAIL  
3  
SCALE: NTS

REPLACE WITH SOD  
TO MATCH EXISTING  
EXISTING GRASS  
COMPACTED NATIVE SOIL  
1 1/2" DIA HOLE (TP)  
RIPING  
18" (AVG)  
18" (AVG)  
COMPACTED NATIVE SOIL  
4" (MIN)

SOIL COVER  
REPLACEMENT DETAIL  
3  
SCALE: NTS

1 1/2" DIA HOLE (TP)  
RIPING  
18" (AVG)  
18" (AVG)  
COMPACTED NATIVE SOIL  
4" (MIN)

## SYMBOLS

MW-12 GROUNDWATER MONITORING WELL

MPA EXISTING BIOMONITORING MONITORING POINT

MPP PROPOSED BIOMONITORING MONITORING POINT

VNT EXISTING VENT WELL

VW3 PROPOSED VENT WELL

PROPOSED HEADER PIPE TO VENT WELL

ESTIMATED AREA OF INFLUENCE


SLOPE



Job No	Described Part	Drawn By	Checked	Drawn On	Approved	Comments	Rec'd Date	Ref No	Date	Description	By
400-NO-728876-28242							A	7/19/95	65X DESIGN	RECD OF DRAWING	

**MONITORING POINT**

DRAWING NO. G-0.3 REV B

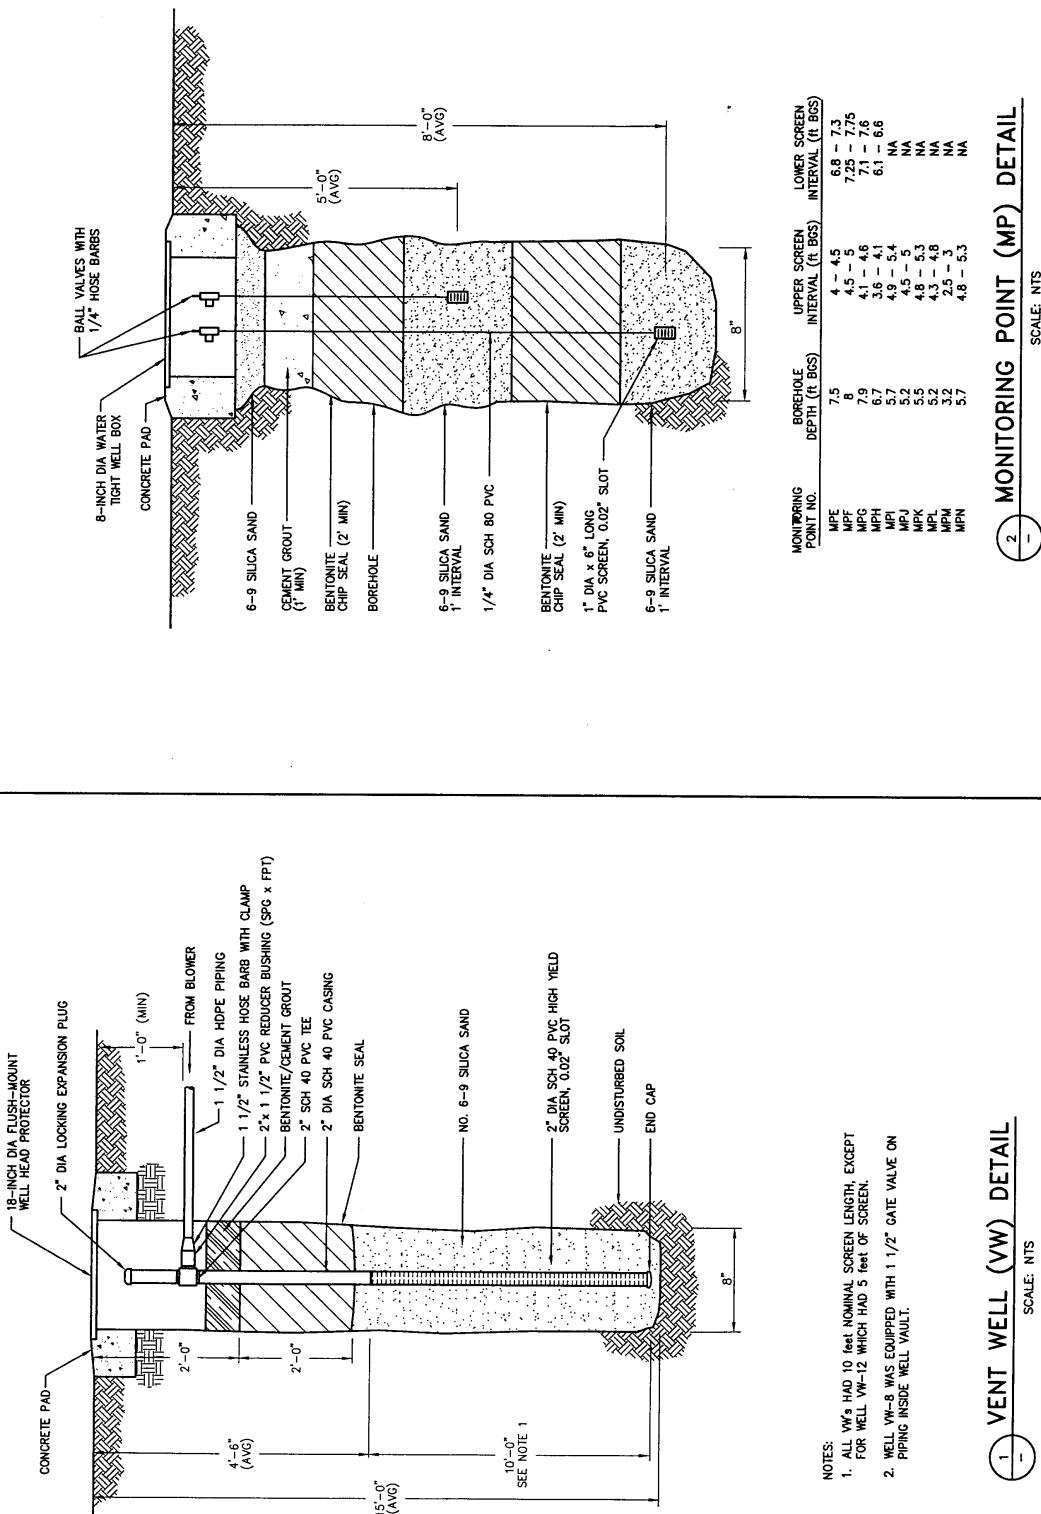


DRAWING NO. G-04  
REV. B

**BLOWER P & ID**

**BLOWER PIPING AND INSTRUMENTATION DIAGRAM**

SCALE: NTS

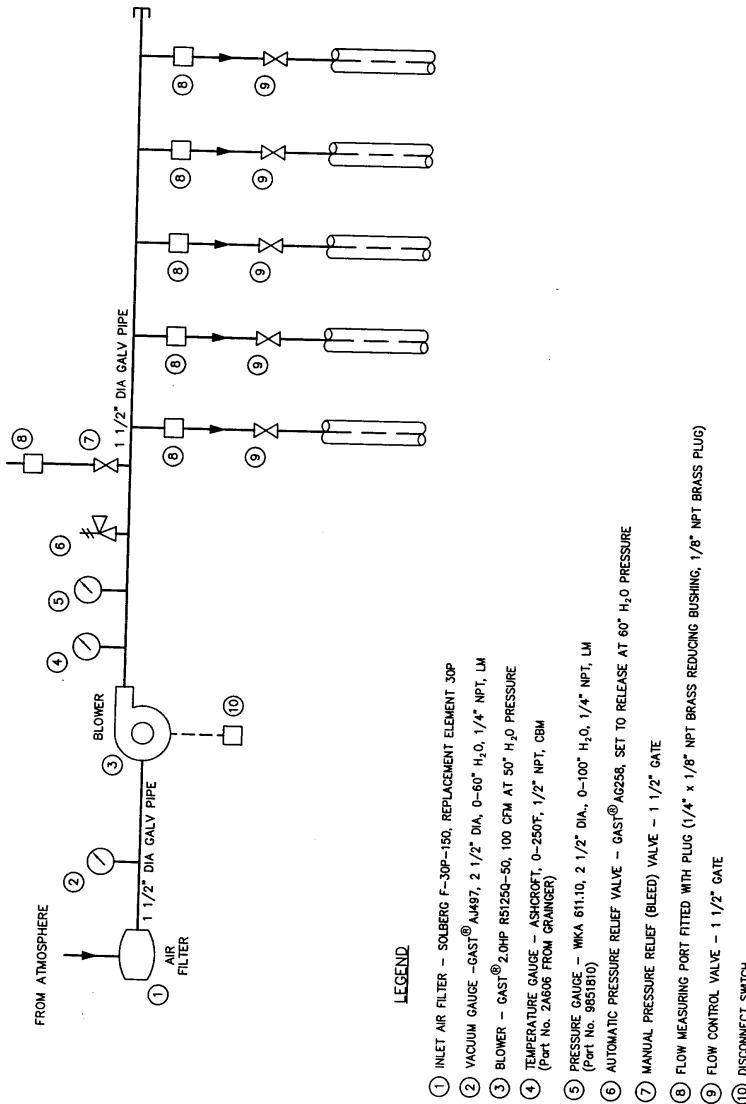

CHARLESTON AIR FORCE BASE
EXPANDED BLEVETING SYSTEM
SITE SS-41

APPROVED
B
7/11/97
RECDRD DRAMIC

REVIEWED
CHIEF

DRIVEN
MW

DESIGNED BY
JDB NO. 72676-28242


DATE
A 7/19/96
55X DESGN

DESIGNER
BY



PARSONS ENVIRONMENTAL EXCELLENCE (APEE)	DRIVEN, CDRD	(303) 831-0100
ENVIRONMENTAL SCIENCE, INC.	Designated R/P	
	Drawn MW	
	Revised	
	Checked	
	Approved	
	Reqd No.	
	Date	
	7/11/97	
	RECDRD DRAMIC	

Job No. 726876-28242	Design Ref. D-100	Drawn, Checked D.C. M.W.	Approved R.B. 7/11/97	Charleston Air Force Base Site SS-41	REV B
006	006	006	006	RECORD DRAWING	
7/19/96	A	7/19/96	B	RECORD DESIGN	
65x DESIGN		65x DRAWING			


- NOTES:
1. SHOP CORE HOLES TO PIPING DIMENSIONS
  2. ALL PIPING 1 1/2" DIA. GALVANIZED STEEL, UNLESS OTHERWISE NOTED
  3. SEE DRAWING G-0-6 FOR BLOWER BUILDING DETAILS
  4. PROVIDE 24" MIN CLEARANCE BETWEEN BLOWER SHEDS

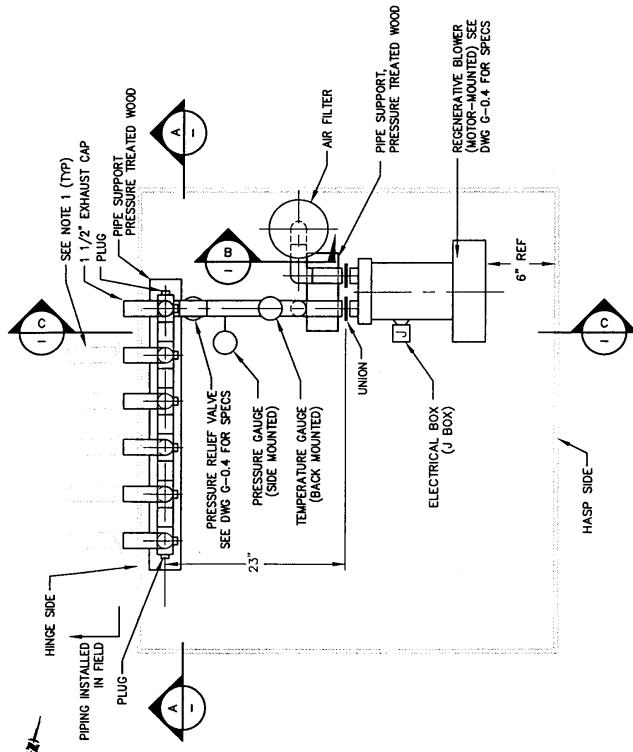


1 BLOWER PIPING LAYOUT PLAN DETAIL (TYPICAL OF TWO)

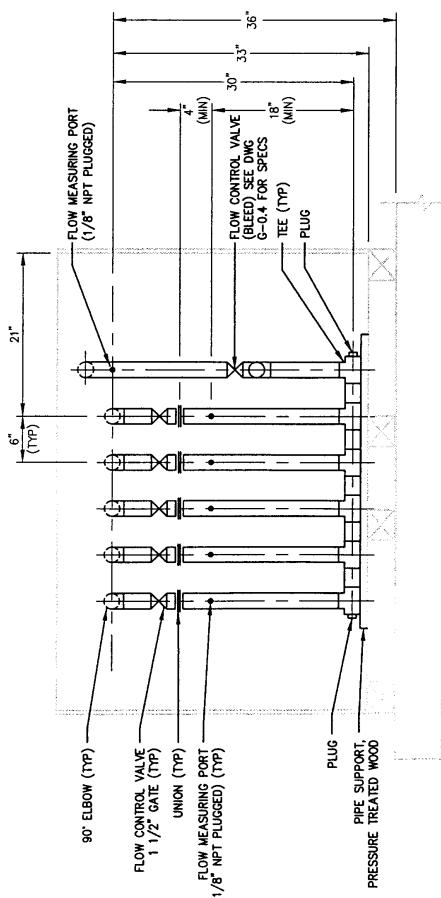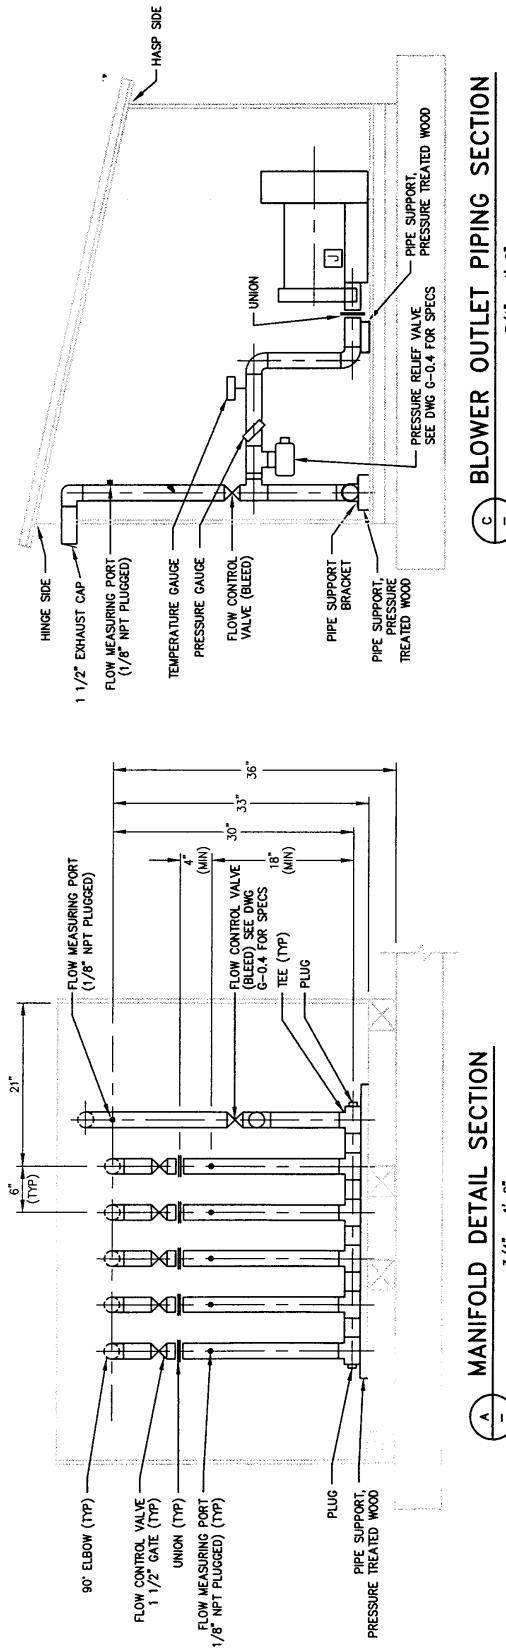

PARSONS ENGINEERING SCIENCE, INC.	PARSONS ENGINEERING SCIENCE, INC.	AIR FORCE CENTER FOR ENVIRONMENTAL EXCELLENCE	EXPANDED BIOMASS SYSTEM SITE SS-41	CHARLESTON AIR FORCE BASE	BLOWER SHED FIELD AND BLOWER SHED CONSTRUCTION DETAILS
Design No 603 NO. 726876-28242	Design No 603 NO. 726876-28240	Driver, Cradles (20) 331-6100	Driver, Cradles (20) 331-6100	Approved Revised Reviewed Checked Drawn M.W.	Date 7/11/97 7/18/96 55 DEG CN RECD BD BY MWS
Approved Revised Reviewed Checked Drawn M.W.	Approved Revised Reviewed Checked Drawn M.W.	Date 7/11/97 7/18/96 55 DEG CN RECD BD BY MWS	Date 7/11/97 7/18/96 55 DEG CN RECD BD BY MWS	Date 7/11/97 7/18/96 55 DEG CN RECD BD BY MWS	Date 7/11/97 7/18/96 55 DEG CN RECD BD BY MWS
00000000000000000000000000000000	00000000000000000000000000000000	00000000000000000000000000000000	00000000000000000000000000000000	00000000000000000000000000000000	00000000000000000000000000000000

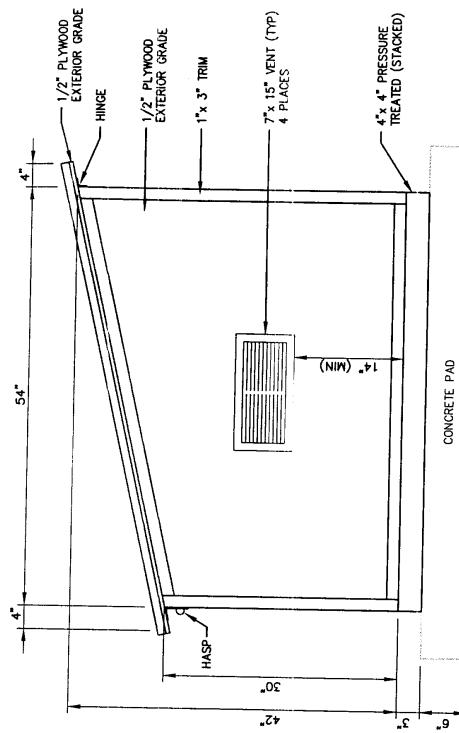

SIDE ELEVATION

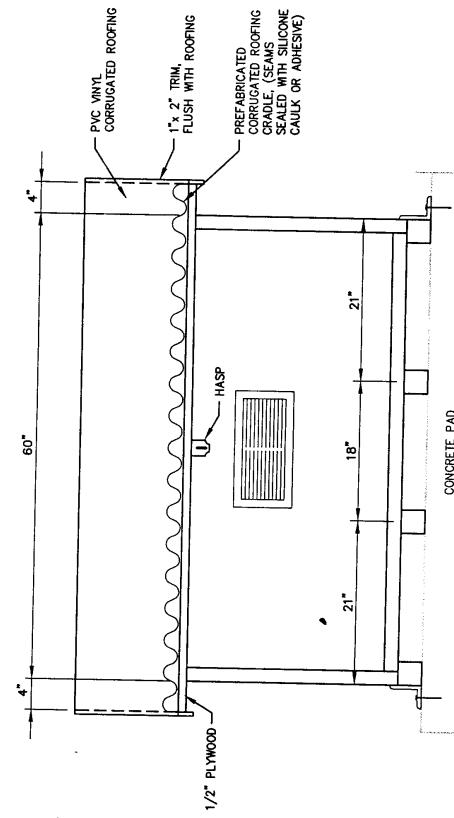


FRONT ELEVATION

NOTES:  
1. 2x2" FRAME CONSTRUCTION  
2. FLOOR CONSTRUCTED OF 3/4" EXTERIOR GRADE PLYWOOD  
3. ROOF CONSTRUCTED OF 1/2" EXTERIOR GRADE PLYWOOD COVERED WITH PVC VINYL CORRUGATED ROOFING


BLOWER SHED CONSTRUCTION DETAIL

NOT TO SCALE

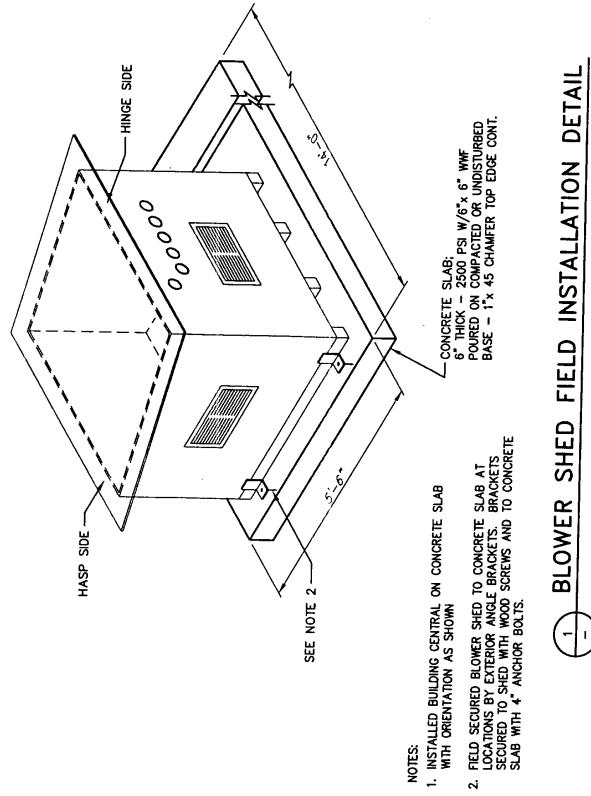

BLOWER SHED FIELD INSTALLATION DETAIL

NOT TO SCALE

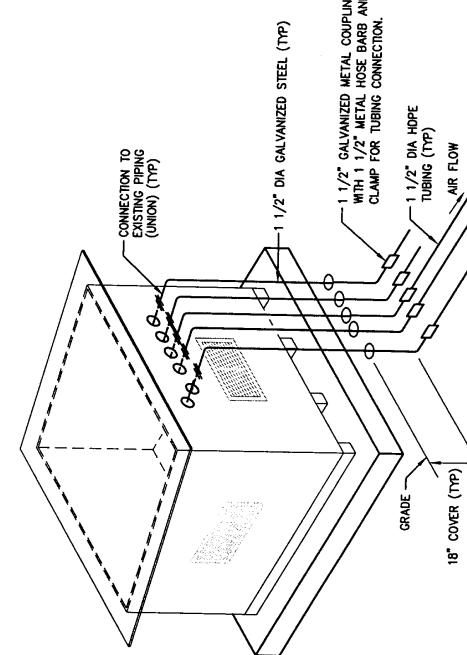

2 TYPICAL MANIFOLD DISCHARGE PIPING LAYOUT

NOT TO SCALE

DRAWING NO  
**G-0.6**

REV  
**B**

**APPENDIX B**

**REGENERATIVE BLOWER INFORMATION**

Gast Manufacturing Corp.  
P.O. Box 97  
Benton Harbor, MI 49023-0097  
(616) 926-6171

## Model R5125Q-50

### Motor Specifications

<u>Phase</u>	<u>Hz</u>	<u>HP</u>	<u>Voltage</u>	<u>Full Load Amps</u>
1	50	2	115 / 230	25 / 12.5

### Overall Dimensions

<u>Height</u>	<u>Width</u>	<u>Depth</u>	<u>Net Weight</u>
13.78 in 350 mm	15.50 in 445 mm	13.56 in 344 mm	77 lb 35 kg

### Performance

<u>Maximum Vacuum</u>	<u>Maximum Pressure</u>	<u>Maximum Flow</u>
60 inH <sub>2</sub> O 149 mbar	55 inH <sub>2</sub> O 137 mbar	160 cfm 272 m <sup>3</sup> h



# SOIL VAPOR EXTRACTION PUMPS - REGENERATIVE BLOWERS

## Product Specifications

Model Number	Phase	Hz	Motor Specifications			Max Vac "H <sub>2</sub> O	mbar	Max Pressure "H <sub>2</sub> O	mbar	Max Flow cfm	m <sup>3</sup> /h	Net. Wt. lbs	kg
			Voltages	HP	Full Load Amps								
R3105N-50	Single	50	110/220-240	.33	3-8/1.9-2.0	28	70	31	77	43	73	52	24
		60	115/208-230	0.5	5.2/2.9-2.6	40	100	43	107	53	90		
R4110N-50	Single	50	110/220-240	0.6	9.2/5.2-4.6	35	87	38	95	74	126	60	28
		60	115/208-230	1.0	11.4/6.2-5.6	48	120	51	127	92	156		
R4310P-50	Three	50	220/380	0.6	3.2/1.6	35	87	38	95	74	126	58	27
		60	208-230/460	1.0	3.4-3.3/1.65	48	120	51	127	92	156		
R4P115N-50	Single	50	110/220-240	1.0	15.2/7.6-8	40	100	45	112	112	190	79	36
		60	115/208-230	1.5	18.2/9.7-9.1	60	149	65	162	133	226		
R5125Q-50	Single	60	115/230	2.0	25/12.5	60	149	55	137	160	272	77	35
		50	190-220/380-415	1.5	5.0-4.4/2.5-2.6	47	117	50	125	133	226		
R5325R-50	Three	60	208-230/460	2.0	6.0-5.6/2.8	60	149	65	162	160	272	75	34
		50	220-240	2.5	14.7-13.5	65	162	75	187	182	309		
R6130Q-50	Single	60	230	3.0	16.3	70	174	60	149	215	365	129	59
		50	190-220/380-415	3.0	14.4-13.4/7.2-6.8	65	162	75	187	180	306		
R6340R-50	Three	60	208-230/460	4.0	13-12/6	80	199	100	249	215	365	112	51
		50	220-240	4.0	20.8-19.1	65	162	80	199	235	399		
R6P155Q-50	Single	60	230	5.5	29.9	85	212	95	237	280	476	243	110
		50	190-220/380-415	4.5	14.9-11/7.45-5.8	65	162	80	199	232	394		
R6P355R-50	Three	60	208-230/460	6.0	20-18/9	85	212	100	249	280	476	233	105
		50	190-220/380-415	8.0	20.8-18.9/10.4-9.5	72	179	80	199	350	595		
R7100R-50	Three	60	208-230/460	10.0	26.5-24/12	90	224	90	224	420	714		



NOTICE: Performance specifications subject to change without notice.

## VACUUM

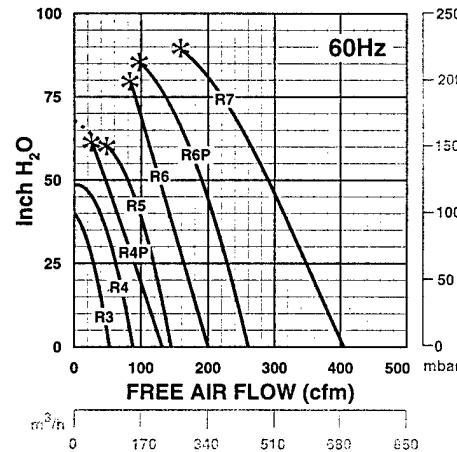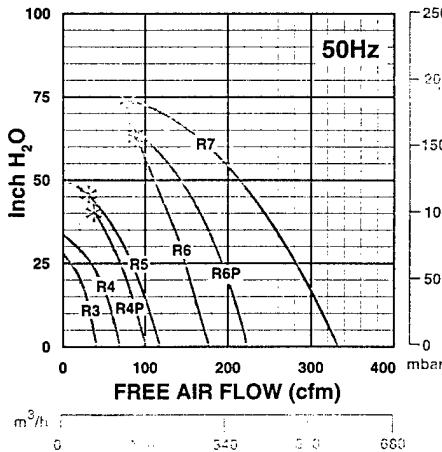


**Free software identifies best Gast blowers for soil and groundwater remediation**

Now you can size and select regenerative blowers and accessories for soil and groundwater remediation systems faster, easier and more accurately than ever before. Gast remediation system engineering software does the job and it is yours for the asking. The 3½-inch IBM-compatible disk calculates performance when the blower is operating with both a vacuum and pressure load at the same time. The programs will also compensate for changes in performance from altitude and temperature, helping you identify the optimum Gast blowers for your application.

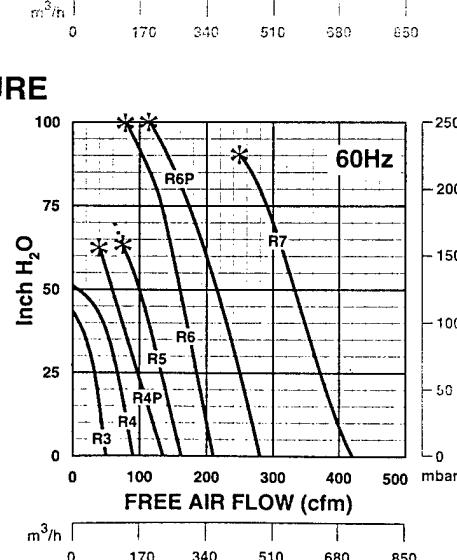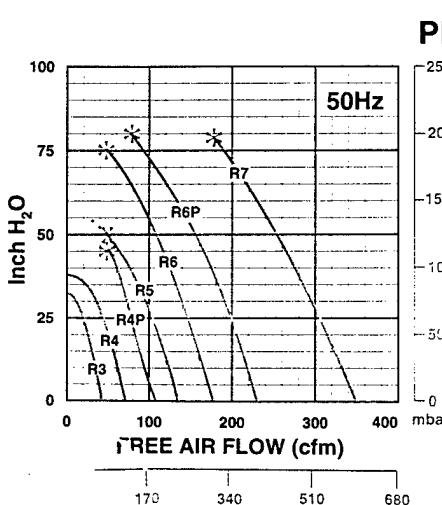


# SOIL VAPOR EXTRACTION PUMPS — REGENERATIVE BLOWERS


Model R3

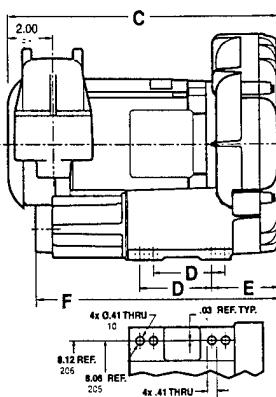

Models R6P, R7

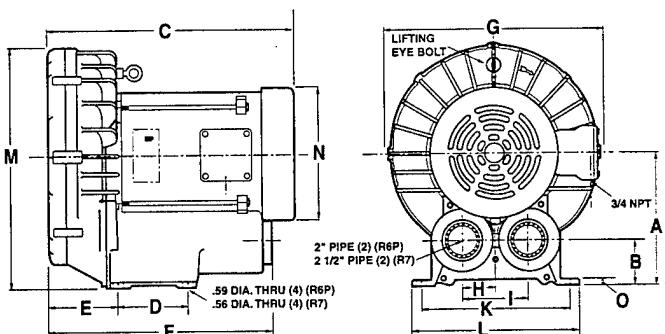

Models R4, R4P, R5, R6

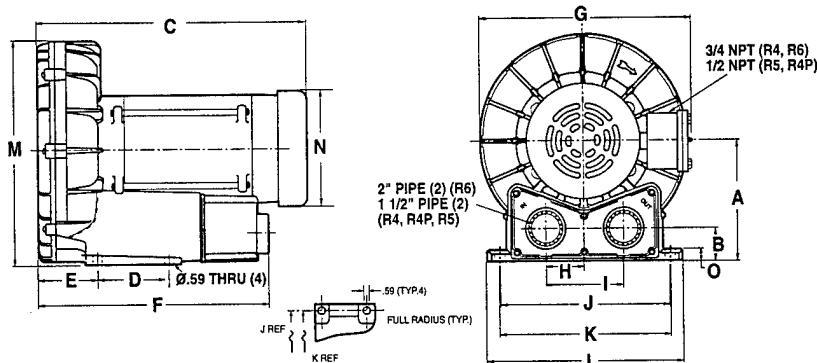


**Product Dimensions** Metric (mm) U.S. Imperial (inches)



Model	A	B	C	D	E	F	G	H	I	J	K	L	M	N	O
R3105N-50	131 5.17	1.25 1.37	12.20	3.25	3.03	11.06	12.75	1.94	3.88	8.06	8.12	9.38	10.15	-	.53
R4110N-50	157 6.18	1.68	15.30	3.75	2.85	12.44	12.31	1.98	3.96	8.86	8.93	10.00	11.73	6.88	.44
R4310P-50	157 6.18	43	355	95	72	316	313	50	101	225	227	254	293	175	.11
R4P115N-50	177 6.98	47	442	114	83	354	338	60	121	260	262	298	346	175	.15
R5125Q-50	178 7.00	46	445	114	91	361	344	60	121	260	262	298	350	173	.15
R5325R-50	178 7.00	46	423	114	91	361	344	60	121	260	262	298	350	183	.15
R6130Q-50	197 7.75	49	511	140	98	404	389	62	125	289	290	329	391	217	.13
R6340R-50	197 7.75	49	478	140	98	404	385	62	125	289	290	329	390	217	.13
R6P155Q-50	248 9.77	80	602	140	137	438	428	64	127	-	290	325	463	257	.50
R6P355R-50	248 9.77	80	554	140	137	438	428	64	127	-	290	325	463	257	.13
R7100R-50	274 10.79	92	577	216	212	545	457	100	200	-	375	410	509	257	.14

Notice: Specifications subject to change without notice.

## REGENAIR® R5 Series

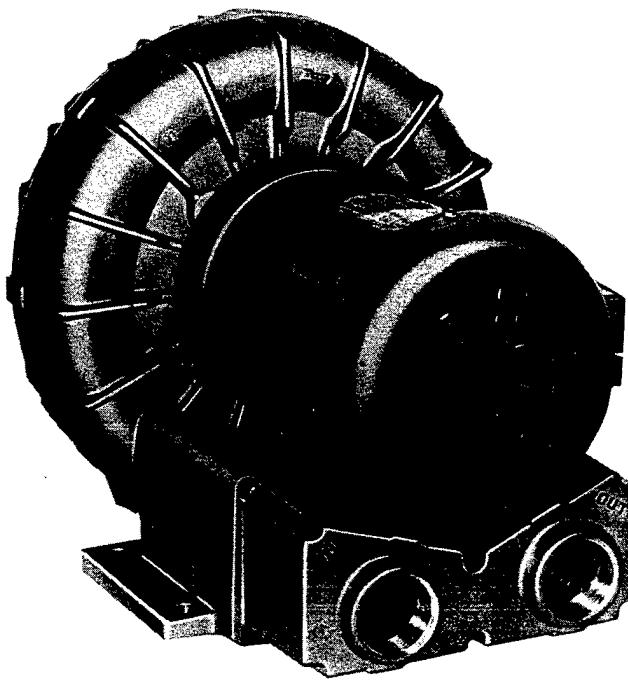

### Product Dimensions Metric (mm) U.S. Imperial (inches)

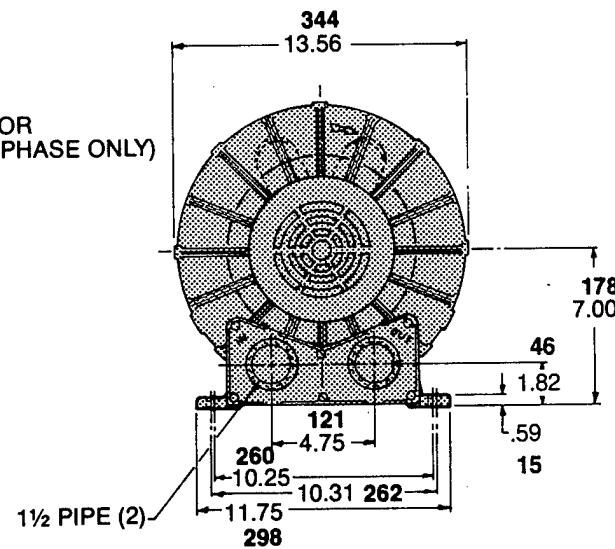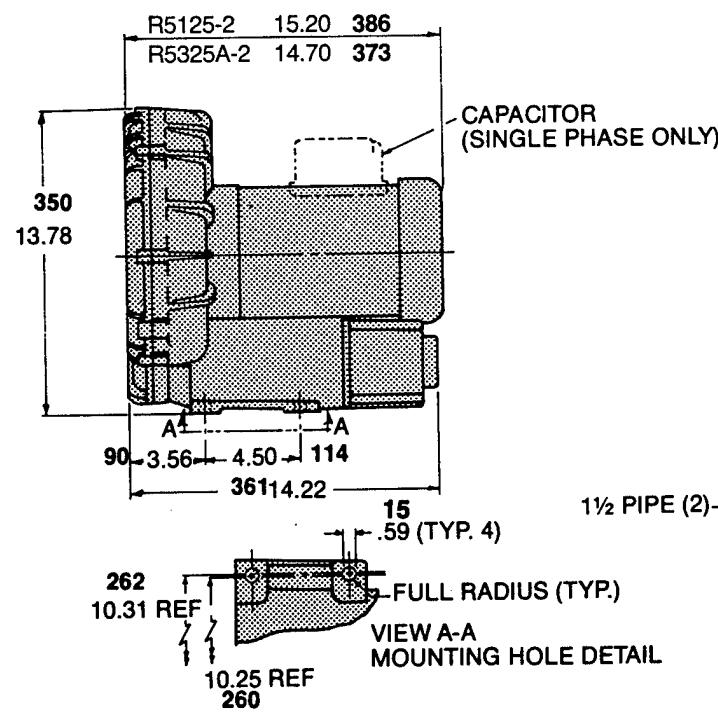

### PRODUCT FEATURES

- Oilless operation
- TEFC motor mounted
- Can be mounted in any plane
- Rugged construction/low maintenance

### COMMON MOTOR OPTIONS

- 115/208-230V, 60 Hz, single phase
- 208-230/460V, 60 Hz; 190-220/380-415V, 50 Hz, three phase
- 575V, 60 Hz, three phase

### RECOMMENDED ACCESSORIES

- Pressure gauge AE133
- Filter AG338
- Muffler AJ121D
- Relief valve AG258

Various brand name motors are used on any model at the discretion of Gast Mfg. Corp.

### Important Notice:



Pictorial and dimensional data is subject to change without notice.

## Product Specifications

Model Number	Motor Specs	Full Load Amps	HP	RPM	Max Pressure "H <sub>2</sub> O	mbar	Max Flow cfm	Max Flow m <sup>3</sup> /h	Net Wt.	
									lbs.	kg
R5325A-2	190-220/380-415-50-3	6.6-6.7/3.3-3.5	1.35	2850	50	125	133	226	65	29,5
	208-230/460-3	6.9/3.45	2.5	3450	65	162	160	272		
R5125-2	115/208-230-60-1	22.4/12.4-11.2	2.5	3450	60	149	160	272	73	33,1

## Product Performance (Metric U.S. Imperial)

Black line on curve is for 60 cycle performance.  
Blue line on curve is for 50 cycle performance.

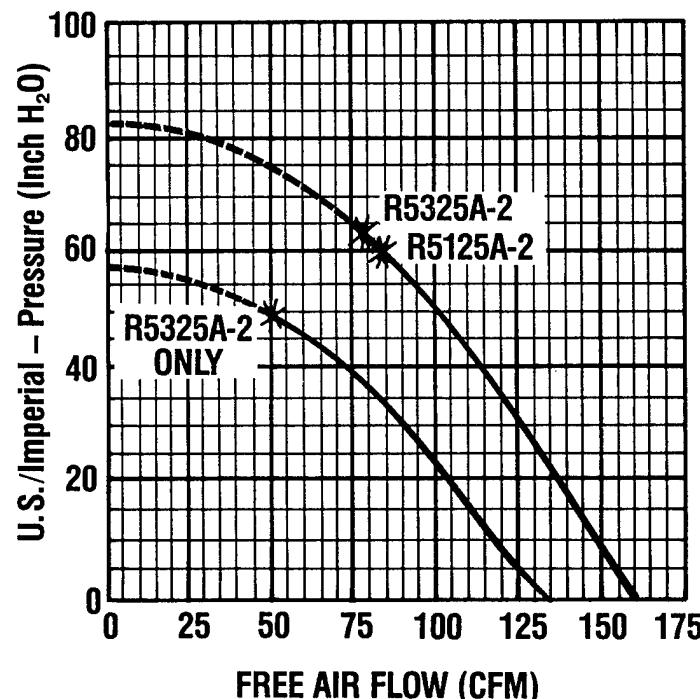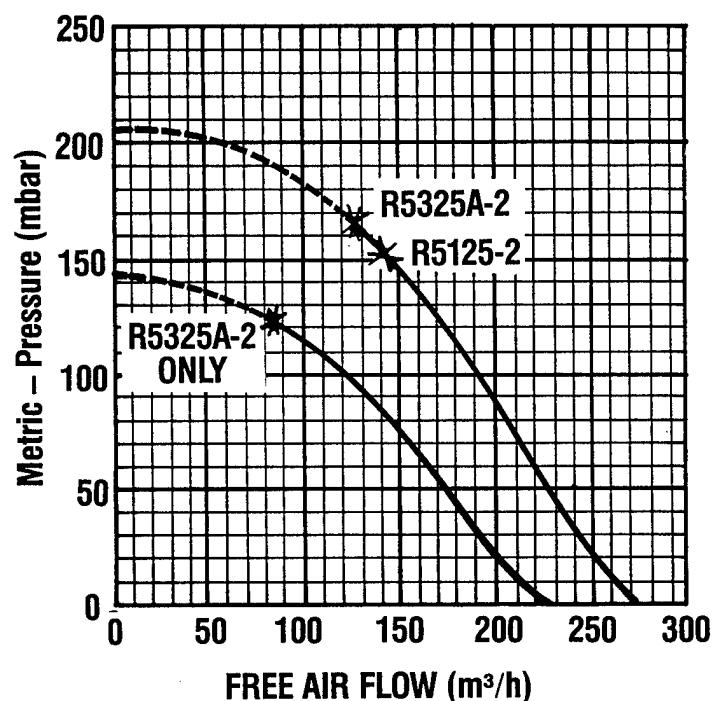


\*Recommended maximum duty.

--- Intermittent duty only.



Post Office Box 97  
Benton Harbor, Michigan 49023-0097  
Ph: 616/926-6171  
Fax: 616/925-8288

## Maintenance Instructions for Gast Standard Regenerative Blowers

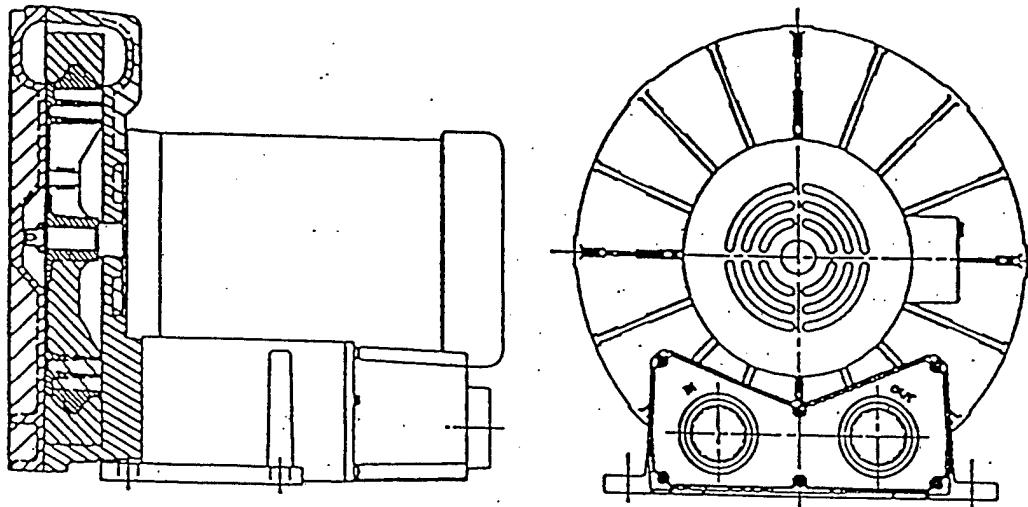

For original equipment manufacturers  
special models, consult your local distributor

### Gast Rebuilding Centers

Gast Mfg. Corp.  
2550 Meadowbrook Rd.  
Benton Harbor MI. 49022  
Ph: 616/926-6171  
Fax: 616/925-8288

Gast Mfg Corp.  
505 Washington Avenue  
Carlstadt, N. J. 07072  
Ph: 201/933-8484  
Fax: 201/933-5545


Brenner Fleider, & Assoc.  
13824 Bentley Place  
Cerritos, CA. 90701  
Ph: 213/404-2721  
Fax: 213/404-7975

Walnbee, Limited  
121 City View Drive  
Toronto, Ont. Canada M9W 5A9  
Ph: 416/243-1900  
Fax: 416/243-2336

Walnbee, Limited  
215 Brunswick Drive  
Pointe Claire, P.Q. Canada H9R 4R7  
Ph: 514/697-8810  
Fax: 514/697-3070

Gast Mfg. Co. Limited:  
Halifax Rd, Cressex Estate  
High Wycombe, Bucks HP12 3SN  
Ph: 44 494 523571  
Fax: 44 494 436588

Japan Machinery Co. Ltd.  
Central PO Box 1451  
Tokyo 100-91 Japan  
Ph: 813/3573-5421  
Fax: 813/3571-7865

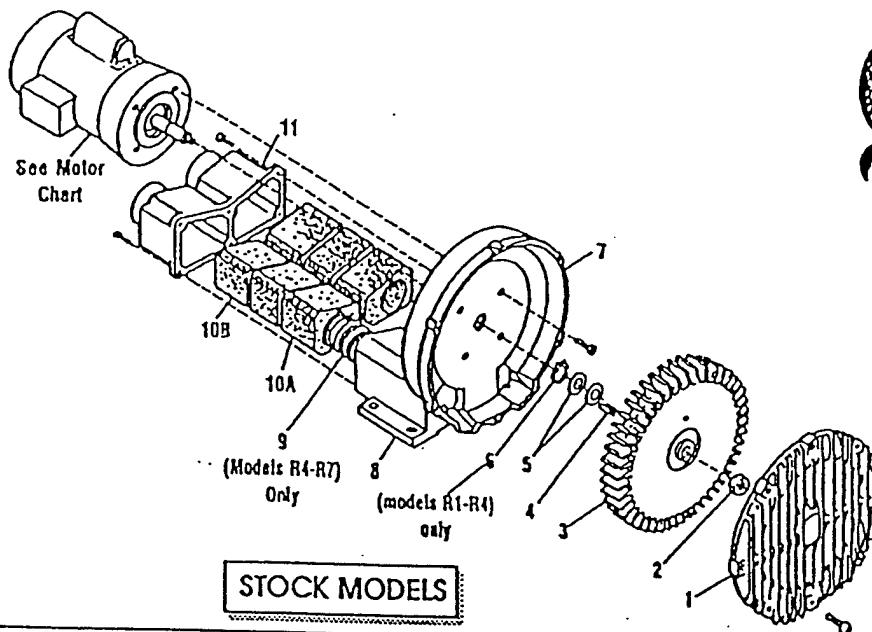

1st

Part Name	R1	R2	R3	R4	R5	R6	R6P	R6PP/R6PS	R7
#1 Cover	AJ101A	AJ101B	AJ101C	AJ101D	AJ101EQ	AJ101F	AJ101K	(2)AJ101KA	AJ101G
#2 Stopnut	BC187	BC187	BC181	BC181	BC181	BC181	BC181	(2)BC182	BC183
#3 Impeller	AJ102A	AJ102BQ	AJ102C	AJ102D	AJ102E	AJ102FR	AJ102K	(2)AJ102KA	AJ102GA
#4 Square Key	AH212C	AH212	AB136A	AB136D	AB136	AB136	AB136	(2)AB136	AC628
#5 Shim Spacer (s)	AJ132	AE686-3	AJ109	AJ109	AJ109	AJ116A	AJ116A	AJ116A	AJ110
#6 Retaining Ring	AJ145	AJ145	AJ149	AJ149					
#7 Housing	AJ103A	AJ103BQ	AJ103C	AJ103DR	AJ103E	AJ103F	AJ103K	AJ103KD	AJ103GA
#8 Muffler Box					AJ104E	AJ104F			
#9 Spring					AJ113DR	AJ113DQ	AJ113FQ	AJ113FQ	
#10A Foam	(4)AJ112A	(4)AJ112B	(4)AJ112C	(4)AJ112DS	(4)AJ112ER	(6)AJ112F	(8)AJ112K		AJ113G
#10B Foam		(2)AJ112BQ	(2)AJ112CQ	(2)AJ112DR	(2)AJ112EQ				(8)AJ112GA
#11 Muffler Extension/ Adapter Plate	AJ106H	AJ106BQ	AJ106CQ	AJ106DQ	AJ106EQ	AJ106EQ	AJ104K		
Shim Kit	K396	K396							AJ104GA K395

### MOTOR CHART

REGENAIR MODEL NUMBER	MOTOR NUMBER	MOTOR SPECIFICATIONS		
		60 HZ VOLTS	50 HZ VOLTS	PHASE
R1102	J111X	115/208-230	110/220-240	1
R1102C	J112X	115		1
R2103	J311X	115/208-230	110/220	1
R2105	J411X	115/208-230	110/220	1
R2303A	J310	208-230/460	220/380-415	3
R2303F	J313	208-230	220	3
R3105-1/R3105-12	J411X	115/208-230	110/220-240	1
R3305A-1/R3305A-13	J410	208-230/460	220/380-415	3
R4110-2	J611AX	115/208-230	110/220-240	1
R4310A-2	J610	208-230/460	220/380-415	3
R5125-2	J811X	115/208-230		1
R5325A-2	J810X	208-230/460	220/380-415	3
R6125-2	J811X	115/208-230		1
R6325A-2	J810X	208-230/460	220/380-415	3
R6315A-2	J910X	208-230/460	220/380-415	3
R6150J-2	J1013	230		1
R6350A-2	J1010	208-230/460	220/380-415	3
R6P335A	J910X	208-230/460	220/380-415	3
R6P350A	J1010	208-230/460	220/380-415	3
R6P355A	J1110A	208-230/460	220/380-415	3
R7100A-2	J1210B	208-230/460	220/380-415	3
R6PP/R6PS3110M	JD1100	208-230/460	220/380-415	3

• No lubrication needed at start up.  
Bearings lubricated at factory.

• Motor is equipped with clemite fitting.  
Clean tip of fitting and apply grease gun.  
Use 1 to 2 strokes of high quality ball  
bearing grease.

Consistency	Type	Typical Grease
Medium	Lithium	Shell Dodium R

Hours of service per year	Suggested Relube Interval
------------------------------	------------------------------

5,000 3 years

Continual Normal Application 1 year

Seasonal service motor  
idle for 6 months or more 1 year beginning  
of season  
6 months

Continuous-high ambient,  
dirty or moist applications.

All performance figures relate to stock models. A few high pressure units may be available. Consult your local distributor.

Regenair Model Number	P R E S S U R E						Maximum Pressure "H <sub>2</sub> O"
	0°H <sub>2</sub> O	20°H <sub>2</sub> O	40°H <sub>2</sub> O	60°H <sub>2</sub> O	80°H <sub>2</sub> O	100°H <sub>2</sub> O	
R1	26	14					28
R2	42	26					38
R3105-1	52	38	14				42
R3105-12	52	36	23				55
R3305A-13	52	36	23				55
R4	90	70	50				55
R5	145	130	100				52
R6125-2	200	180					65
R6325A-2	200	180	152				35
R6335A-2	205	175	155	135			40
R6350A-2	200	180	150	130	110	80	70
R6P335A	290	250					105
R6P350A	300	260	230	200			30
R6P355A	300	260	230	200	160		60
R7100A-2	420	380	340	310	280	230	90
R6PP311OM	465	452	420	380	330		115
R6PS311OM	265	258	252	244	236	226	170

Regenair Model Number	V A C U U M						Maximum Vacuum "H <sub>2</sub> O"
	0°H <sub>2</sub> O	20°H <sub>2</sub> O	40°H <sub>2</sub> O	60°H <sub>2</sub> O	80°H <sub>2</sub> O		
R1	25	14					26
R2	40	22					34
R3105-1	50	34	9				40
R3105-12	51	34	20				50
R3305A-13	51	34	20				50
R4	82	62	39				48
R5	140	115	90	50			60
R6125-2	190	155	125				45
R6325A-2	190	155	125				45
R6335A-2	190	150	125	100			75
R6350A-2	190	180	150	100	70		90
R6P335A	270	230					37
R6P350A	280	240	210	170			70
R6P355A	280	240	210	170	100		86
R7100A-2	410	350	300	250	170		90
R6PP311OM	470	425	375	320	220		80
R6PS311OM	240	225	210	195	175		130

\*This number indicates the maximum static pressure differential recommended (with cooling air still flowing through unit). In general, units 1hp or less can be dead headed. Check with local representative or distributor to verify which models apply.

Operation of the blower above the recommended maximum duty will cause premature failure due to the build up of heat damaging the components.

Performance data was determined under the following conditions:

- 1) Unit in a temperature stable condition.
- 2) Test conditions: Inlet air density of 0.075lbs. per cubic foot. (20°C(68°F), 29.92 in. Hg(14.7PSIA)).
- 3) Normal performance variations on the resistance curve within +/- 10% of supplied data can be expected.
- 4) Specifications subject to change without notice.
- 5) All performance at 60Hz operation.



Post Office Box 97  
Benton Harbor, MI. 49023-0097  
Ph: 616/926-6171  
Fax: 616/925-8288

70-5100-2  
F2-205/8/9  
Rev E 14

# INSTALLATION AND OPERATING INSTRUCTIONS FOR GAST HAZARDOUS DUTY REGENAIR BLOWERS

This instruction applies to the following models ONLY: R3105N-50, R4110N-50, R4310P-50, R4P115N-50, R5125Q-50, R5325R-50, R6130Q-50, R6P155Q-50, R6350R-50, R6P355R-50 and R7100R-50.

Gast Authorized Service Facilities are Located in the locations listed below

Gast Manufacturing Corporation  
505 Washington Avenue  
Carlstadt, N. J. 07072  
Ph: 201/933-8484  
Fax: 201/933-5545

Gast Manufacturing Corporation  
2550 Meadowbrook Road  
Benton Harbor, MI. 49022  
Ph: 616/926-6171  
Fax: 616/925-8288

Brenner Fledler & Associates Wainbee Limited  
13824 Bentley Place  
Cerritos, CA. 90701  
Ph: 310/404-2721  
Ph: 800/843-5558  
Fax: 310/404-7975

215 Brunswick Blvd.  
Pointe Claire, Quebec  
Canada H9R 4R7  
Ph: 514/697-8810  
Fax: 514/-697-3070

Wainbee Limited  
5789 Coopers Ave.  
Mississauga, Ontario  
Canada L4Z 3S6  
Ph: 416/243-1900  
Fax: 416/243-2336

Japan Machinery  
Central PO Box 1451  
Toyko 100-91, Japan  
Ph: 813 3573-5421  
Fax: 813 3571-7896

Gast Manufacturing Co. Ltd.  
Halifax Road, Cressex Estate  
High Wycombe, Bucks HP12 3SN  
England  
Ph: 44 494 523571  
Fax: 44 494 436588

## OPERATING AND MAINTENANCE INSTRUCTIONS

### SAFETY

This is the safety alert symbol. When you see this symbol personal injury is possible. The degree of injury is shown by the following signal words:

**DANGER** Severe injury or death will occur if hazard is ignored.

**WARNING** Severe injury or death can occur if hazard is ignored.

**CAUTION** Minor injury or property damage can occur if hazard is ignored.

Review the following information carefully before operating.

### GENERAL INFORMATION

*This instruction applies to the following models ONLY: R3105N-50, R4110N-50, R4310P-50, R4P115N-50, R5125Q-50, R5325R-50, R6130Q-50, R6P155Q-50, R6350R-50, R6P355R-50 and R7100R-50.* These blowers are intended for use in Soil Vapor Extraction Systems. The blowers are sealed at the factory for very low leakage. They are powered with a U.L. listed electric motor Class I Div. 1 Group D motors for Hazardous Duty locations. Ambient temperature for normal full load operation should not exceed 40° C (105° F). For higher ambient operation, contact the factory.

Gast Manufacturing Corporation may offer general application guidance; however, suitability of the particular blower and/or accessories is ultimately the responsibility of the user, not the manufacturer of the blower.

### INSTALLATION

**DANGER** Models R5325R-50, R6130Q-50, R6350R-50, R5125Q-50, R6P155Q-50, R6P355R-50 AND R7100R-50 use Pilot Duty Thermal Overload Protection. Connecting this protection to the proper control circuitry is mandated by UL674 and NEC501. Failure to do so could may result in a EXPLOSION. See pages 3 and 4 for recommended wiring schematic for these models.

**WARNING** Electric shock can result from bad wiring. A qualified person must install all wiring, conforming to all required safety codes. Grounding is necessary.

**WARNING** This blower is intended for use on soil vapor extraction equipment. Any other use must be approved in writing by Gast Manufacturing Corp. Install this blower in any mounting position. Do not block the flow of cooling air over the blower and motor.

**PLUMBING** - Use the threaded pipe ports for connection only. They will not support the plumbing. Be sure to use the same or larger size pipe to prevent air flow restriction and overheating of the blower. When installing fittings, be sure to use pipe thread sealant. This protects the threads in the blower housing and prevents leakage. Dirt and chips are often found in new plumbing. Do not allow them to enter the blower.

**NOISE** - Mount the unit on a solid surface that will not increase the sound. This will reduce noise and vibration. We suggest the use of shock mounts or vibration isolation material for mounting.

**ROTATION** - The Gast Regenair Blower should only rotate clockwise as viewed from the electric motor side. The casting has an arrow showing the correct direction. Confirm the proper rotation by checking air flow at the IN and OUT ports. If needed reverse rotation of three phase motors by changing the position of any two of the power line wires.

### OPERATION

**WARNING** Solid or liquid material exiting the blower or piping can cause eye damage or skin cuts. Keep away from air stream.

**WARNING** - *Gast Manufacturing Corporation will not knowingly specify, design or build any blower for installation in a hazardous, combustible or explosive location without a motor conforming to the proper NEMA or U. L. standards.* Blowers with standard TEFC motors should never be utilized for soil vapor extraction applications or where local state and/or Federal codes specify the use of explosion-proof motors (as defined by the National Electric Code, Articles 100,500 c1990).

**CAUTION** Attach blower to solid surface before starting to prevent injury or damage from unit movement. Air containing solid particles or liquid must pass through a filter before entering the blower. Blowers must have filters, other accessories and all piping attached before starting. Any foreign material passing through the blower may cause internal damage to the blower.

**CAUTION** Outlet piping can burn skin. Guard or limit access. Mark "CAUTION Hot Surface. Can Cause Burns". Air temperature increases when passing through the blower. When run at duties above 50 in. H<sub>2</sub>O metal pipe may be required for hot exhaust air. The blower must not be operated above the limits for continuous duty. Only models R3105N-50, R4110N-50 and R4310P-50 can be operated continuously with no air flowing through the blower. Other units can only be run at the rating shown on the model number label. Do not Close off inlet (for vacuum) to reduce extra air flow. This will cause added heat and motor load. Blower exhaust air in excess of 230°F indicates operation in excess of rating which can cause the blower to fail.

**ACCESSORIES** ...Gast pressure gauge AJ496 and vacuum gauges AJ497 or AE134 show blower duty. The Gast pressure/vacuum relief valve, AG258, will limit the operating duty by admitting or relieving air. It also allows full flow through the blower when the relief valve closes.

## SERVICING


**WARNING** To retain their sealed construction they should be serviced by Gast authorized service centers ONLY. These models are sealed at the factory for very low leakage.

**WARNING** Turn off electric power before removing blower from service. Be sure rotating parts have stopped. Electric shock or severe cuts can result. Inlet and exhaust filters attached to the blower may need cleaning or replacement of the elements. Failure to do so will result in more pressure drop, reduced air flow and hotter opera-

tion of the blower. The outside of the unit requires cleaning of dust and dirt. The inside of the blower also may need cleaning to remove foreign material coating the impeller and housing. This should be done at a Gast Authorized Service Center. This buildup can cause vibration, failure of the motor to operate or reduced flow.

**KEEP THIS INFORMATION WITH THIS BLOWER.  
REFER TO IT FOR SAFE INSTALLATION,  
OPERATION OR SERVICE.**


MOTOR WIRING DIAGRAM FOR R4110N-50 & R3105N-50

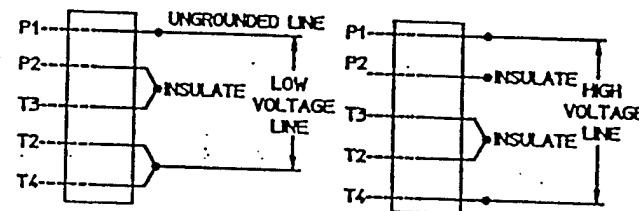

>>\* **WARNING**  
THIS MOTOR IS THERMALLY PROTECTED AND WILL AUTOMATICALLY RESTART WHEN PROTECTOR RESETS. ALWAYS DISCONNECT POWER SUPPLY BEFORE SERVICING.

MOTORS WIRING DIAGRAM FOR R4310P-50


TO REVERSE ROTATION,  
INTERCHANGE THE  
EXTERNAL CONNECTIONS  
TO ANY TWO LEADS.

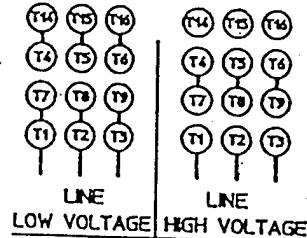



>>\* **WARNING**  
THIS MOTOR IS THERMALLY PROTECTED AND WILL AUTOMATICALLY RESTART WHEN PROTECTOR RESETS. ALWAYS DISCONNECT POWER SUPPLY BEFORE SERVICING.

MOTORS WIRING DIAGRAM FOR  
R5325R-50, R6350R-50, R6P355R-50, & R7100R-50

TO REVERSE ROTATION,  
INTERCHANGE THE  
EXTERNAL CONNECTIONS  
TO ANY TWO LEADS.

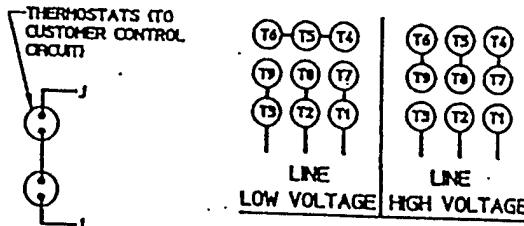


## MOTOR WIRING DIAGRAM FOR R5125Q-50 & R4P115N-50

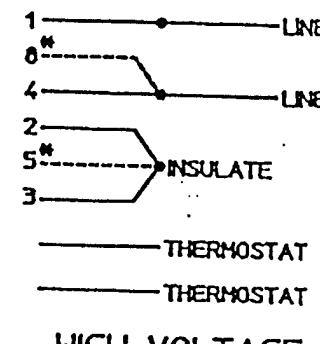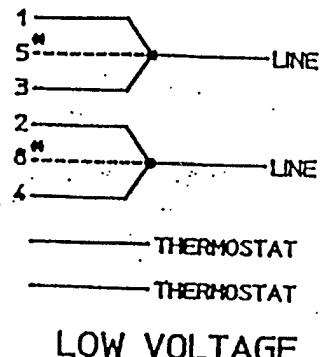


\* R5125Q-50 BLOWERS PRODUCED AFTER SEPTEMBER 1992 (SER. NO. 0992) DO NOT HAVE MOTOR LEADS 5 & 6.

## MOTOR WIRING DIAGRAM FOR R6130Q-50 & R6P155Q-50

CONNECT THERMOSTAT  
TO MOTOR PROTECTION  
CIRCUIT

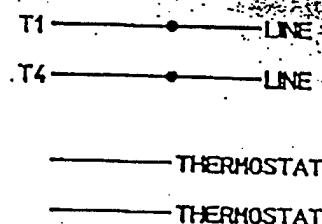

## CONNECTION FOR THERMOSTAT MOTOR PROTECTION

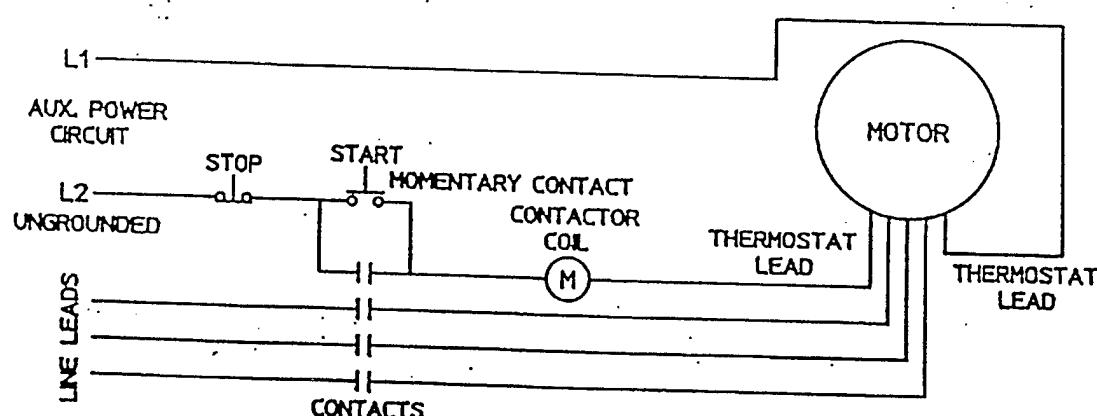


TERMOSTATS TO BE CONNECTED IN SERIES WITH  
CONTROL AS SHOWN. MOTOR FURNISHED WITH  
AUTOMATIC THERMOSTATS RATED A.C. 115-600V. 720VA

# ACCESSORIES

## Moisture Separators

Moisture separators remove liquids from the gas stream in a vacuum process, helping protect the blower from corrosion and a buildup of mineral deposits.

Part No.	Liq. Cap. (gal.)	A(dia.)	Dim. B	C(NPT)	D(dia.)	Dim. E	Dim. F
RMS160	10	14.8"	37.5"	2"	2"	7.5"	26.6"
RMS200	19	19.7"	35"	2"	2"	7.5"	26.6"
RMS300	19	19.7"	35"	2.5"	2.5"	7.5"	26.6"
RMS400	40	24"	44"	3"	3"	9.7"	29"

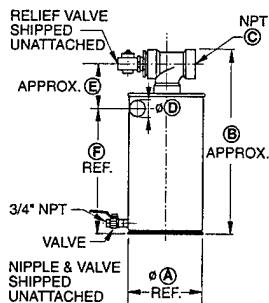

## Part No. Product Type Description

Part No.	Product Type	Description	Used On
RMS160	Moisture separator	10 gallon liquid carrying capacity	R3, R4, R4P, R5 Blowers
RMS200	Moisture separator	19 gallon liquid carrying capacity	R4, R4P, R5, R6 Blowers
RMS300	Moisture separator	19 gallon liquid carrying capacity	R5, R6, R6P Blowers
RMS400	Moisture separator	40 gallon liquid carrying capacity	R6P, R7 Blowers
—	Float switch	Consult factory for appropriate style	RMS Series-Separators

## Filters

Since the blower impeller passes very close to the housing, it is always wise to have an in-line or inlet filter to ensure trouble free life.

### In-line (for vacuum)

Part No.	Dim. A	Dim. B	Dim. C	Dim. D	Dim. E
AJ151C	7.38"	6.81"	4.62"	1-1/4" FPT	1-1/4" FPT
AJ151D	7.38"	6.81"	4.62"	1-1/2" FPT	1-1/2" FPT
AJ151E	8.75"	10.25"	5.00"	2" FPT	2" FPT
AJ151G	8.00"	10.25"	5.50"	2-1/2" FPT	2-1/2" FPT
AJ151H	14.00"	26.50"	18.13"	3" MPT	3" MPT
AJ151L	14.00"	27.13"	18.50"	4" MPT	4" MPT

MPT = Male Pipe Thread FPT = Female Pipe Thread

All are heavy-duty for high amounts of particulates.


Inlet filters for REGENAIR® blowers are drip-proof when mounted as shown.

### For Vacuum Service

AJ151C	In-line filter	10 micron filter (replacement element AJ135E)	R3 Blower, R1H
AJ151D	In-line filter	10 micron filter (replacement element AJ135E)	R4, R4P, R3H Blowers, R2H
AJ151E	In-line filter	10 micron filter (replacement element AJ135F)	R5, R4H Blowers
AJ151G	In-line filter	10 micron filter (replacement element AJ135G)	R6, R6P Blowers, R7H, R8H, R9H
AJ151H	In-line filter	10 micron filter (replacement element AJ135C)	R7 Blower
AJ151L	In-line filter	10 micron filter (replacement element AJ135C)	R8M Blower

### Inlet (for pressure units only)

Part No.	Dim. A	Dim. B	Dim. C
AJ126C	6.00"	7.12"	1-1/4" MPT
AJ126D	7.70"	7.25"	1-1/2" MPT
AJ126F	10.63"	4.81"	2" FPT
AJ126G	10.00"	13.12"	2-1/2" MPT
AJ126L	10.00"	14.62"	4" MPT

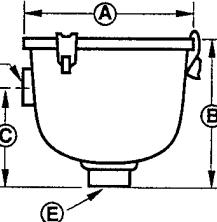

MPT = Male Pipe Thread FPT = Female Pipe Thread

All are heavy-duty for high amounts of particulates.

Inlet filters for REGENAIR® blowers are drip-proof when mounted as shown.

### For Compressor-Inlet

AJ126C	Inlet filter	10 micron filter (replacement element AJ134C)	R3 Blower, R1H, 2067, 2567
AJ126D	Inlet filter	10 micron filter (replacement element AJ134E)	80 Series, 6066, 1290, R4, R4P, R5, R3H Blowers
AJ126F	Inlet filter	25 micron filter (replacement element AG340)	R6, R6P, R4H Blowers
AJ126G	Inlet filter	10 micron filter (replacement element AJ135A)	R7 Blower, R7H, R8H
AJ126L	Inlet filter	10 micron filter (replacement element AJ135H)	R8H Blower
AL355	Inlet filter	10 micron filter	0823

# ACCESSORIES




## Pressure-Vacuum Gauge

To monitor the system performance so maximum duties are not exceeded. Using two gauges (one on each side of the filter) is a great way to know when the filter needs servicing.

AJ497	Vacuum gauge	0-60" H <sub>2</sub> O, 1/4" NPT connection	Blowers
AE134	Vacuum gauge	0-160" H <sub>2</sub> O, 1/4" NPT connection	Blowers
AE134F	Vacuum gauge	0-15" HG, 1/4" NPT connection	H Series Blowers
AA644B	Pressure gauge	0-30 psi, 1/4" NPT	80 Series, 2567, 2067, 6066, 0823
AE133	Pressure gauge	0-160" H <sub>2</sub> O, 1/4" NPT connection	Blowers
AE133A	Pressure gauge	0-200" H <sub>2</sub> O, 1/4" NPT connection	Blowers
AE133F	Pressure gauge	0-15 psi, 1/4" NPT connection	R3H, R4H Blowers
AJ496	Pressure gauge	0-60" H <sub>2</sub> O, 1/4" NPT connection	SVE Blowers

## Check Valve

Designed to prevent back-wash of fluids that would enter the blower. Also prevents air back-streaming if needed. Can be mounted with discharge either vertical or horizontal. Valve will open with 3" of water pressure.

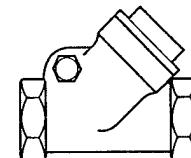

AH326D	Check valve	1-1/2" NPT (3" H <sub>2</sub> O cracking pressure)	Blowers
AH326F	Check valve	2" NPT (3" H <sub>2</sub> O cracking pressure)	Blowers
AH326G	Check valve	2-1/2" NPT (3" H <sub>2</sub> O cracking pressure)	R7 Blower

## Relief Valve


By setting a relief valve at a given pressure/vacuum you can ensure excessive duties will not harm the blower or products in your application.



AA307	Relief valve	For pressure, 3/4" NPT, adjustable 2-25 psi	6066, 2567 Series
AA600	Relief valve	For pressure, 3/8" NPT, adjustable 2-30 psi	0823
AG258	Relief valve	1-1/2" NPT adjustable 30-170" H <sub>2</sub> O, vac. or press., 200 CFM max.	Blowers
AG258F	Relief valve	2-1/2" NPT adjustable for higher flows, vacuum or pressure	Blowers
PV065	Relief valve	For pressure, pre-set for 6.5 psi, 1-1/4" NPT connection (60Hz)	R3H Blower
PV072	Relief valve	For pressure, pre-set for 7.2 psi, 1-1/4" NPT connection (60Hz)	R3H Blower
PV084	Relief valve	For pressure, pre-set for 8.4 psi, 1-1/4" NPT connection (50Hz)	R4H Blower, R8H, R9H
PV091	Relief valve	For pressure, pre-set for 9.1 psi, 1-1/4" NPT connection (50Hz)	R4H Blower, R9H
PV098	Relief valve	For pressure, pre-set for 9.8 psi, 1-1/4" NPT connection (50Hz)	R7H Blower
PV102	Relief valve	For pressure, pre-set for 10.2 psi, 1-1/4" NPT connection (60Hz)	R7H Blower
AN225	Relief valve	15-45 cfm, 3/4" NPT connection, adjustable 0-20 psi	2080, 3080, 4080 Series

## Service Kit

If pump performance on rotary vane models diminishes, installation of the Service Kit replacement parts will have it performing like new again.

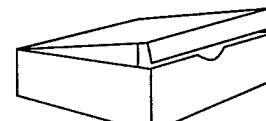


K479A	Service Kit	Includes items for unit repair	0823 Model
K504	Service Kit	Includes items for unit repair	6066, 1290 (uses 2)
K583	Service Kit	Includes items for unit repair	2567 Models
K584	Service Kit	Includes items for unit repair	2080, 3080, 4080 Models
K585	Service Kit	Filter/Muffler Kit only	2080, 3080, 4080 Models

# North American Representatives and Distributors

A substantial stock of vacuum pumps, compressors, air motors, parts and accessories are carried by the offices listed below.

- (A) Distributor-plant-use sales only.
- (B) Manufacturers Representative - O.E.M. and plant-use sales.
- (C) Gast warehouse and sales office - O.E.M. and plant-use sales.
- (D) Gast service center.

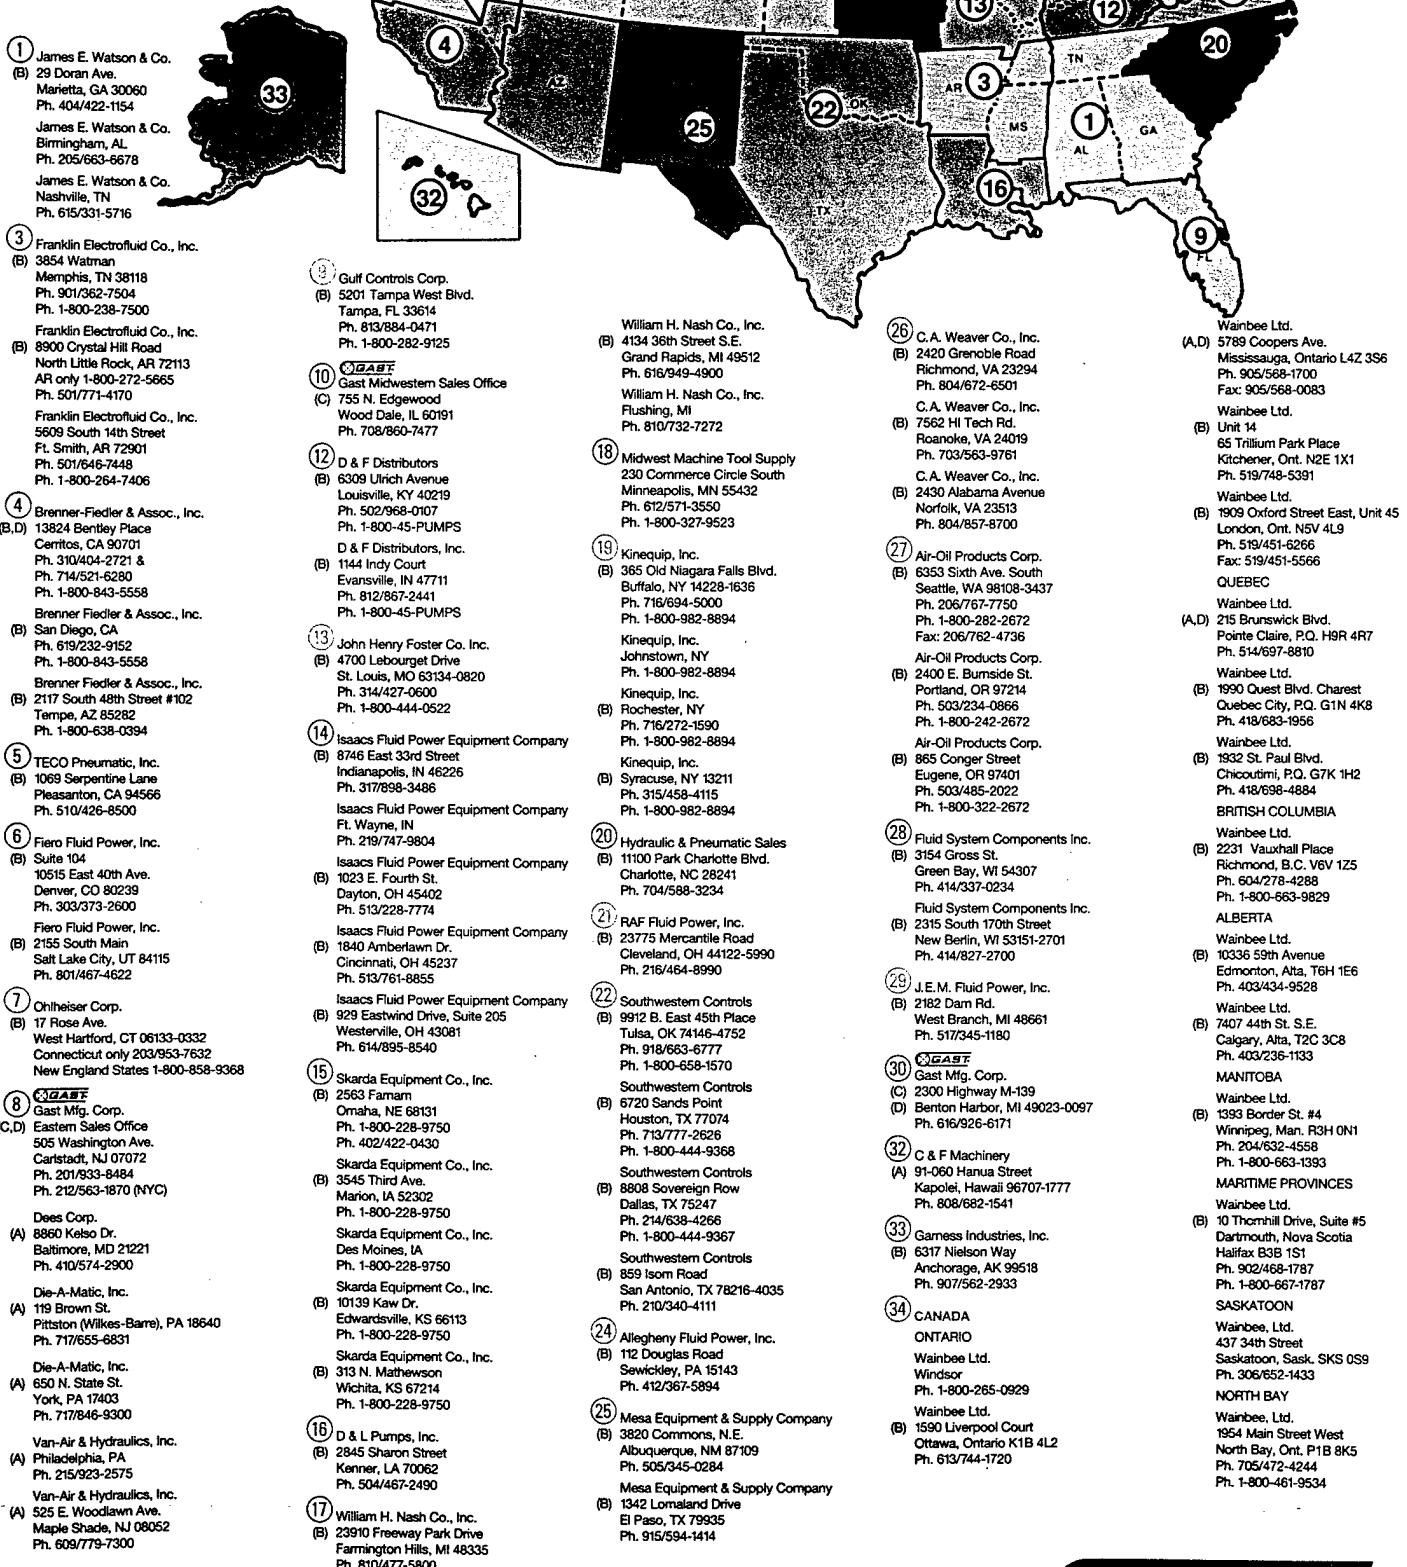

# CONVERSION CHARTS

## PRESSURE CONVERSION TABLE

Lbs. Per Sq. Inch	Atmospheres	Inches of Mercury	Millimeters of Mercury	Inches of Water	Meters of Water	Milli Bars	Kilopascals
1	.0680	2.036	51.71	27.73	.7037	69.0	6.895
14.70	1	29.92	760	407	10.33	1013.3	101.36
.4912	.0334	1	25.4	13.6	.3452	33.86	3.387
.0193	.001315	.03937	1	.5358	.0136	1.33	.13307
.0361	.00246	.0735	1.868	1	.0254	2.49	.24891
1.422	.0967	2.895	73.55	39.37	1	97.98	9.8047
14.50	.0009869	.02953	.750	.4018	.01021	1	.09998
.145	.00986	.29529	7.4996	4.0174	.10206	10.01	1

## VOLUME FLOW CONVERSION TABLE

cfm	cfh	gpm	m³/h	l/s
1	60	7.4805	1.6990	.47195
1/60	1	.12468	.02832	.007866
.13368	8.0208	1	.22712	.06309
.58858	35.315	4.4029	1	1/3.6
2.1189	127.13	15.850	3.6	1

## Power and Heat Flow Conversion Table

hp(U.S.)	ft.lb/min	Btu/hr	Btu/min	W	kcal/min
1	33000	2544.4	42.407	745.70	10.686
.000030303	1	.07710	.001285	.02260	.0003238
.0003930	12.969	1	1/60	.29307	.004200
.02358	778.17	60	1	17.584	.25200
.00134	44.254	3.4121	.05687	1	.01433
.09358	3088.0	238.10	3.9683	69.780	1

## Temperature Conversion Chart

$$^{\circ}\text{C} = \frac{5}{9} (\text{ }^{\circ}\text{F} - 32)$$

$$\text{Absolute Kelvin} = ^{\circ}\text{C} + 273.15$$

$$^{\circ}\text{F} = \frac{9}{5} ^{\circ}\text{C} + 32$$

$$\text{Rankine } ^{\circ}\text{F} = +459.67$$

### TABLE EXAMPLE:

To Convert 100 °C to °F look up 100 read left

To Convert 100 °F to °C look up to 100 read right

to °F	From	to °C
-148.0	-100	-73.33
-130.0	-90	-67.78
-112.0	-80	-62.22
-94.0	-70	-56.67
-76.0	-60	-51.11
-58.0	-50	-45.56
-40.0	-40	-40.00
-36.4	-38	-38.89
-32.8	-36	-37.78
-29.2	-34	-36.67
-25.6	-32	-35.56
-22.0	-30	-34.44
-18.4	-28	-33.33
-14.8	-26	-32.22
-11.2	-24	-31.11
-7.6	-22	-30.00
-4.0	-20	-28.89
-0.4	-18	-27.78
+3.2	-16	-26.67
+6.8	-14	-25.56
+10.4	-12	-24.44
+14.0	-10	-23.33
+17.6	-8	-22.22
+21.2	-6	-21.11
+24.8	-4	-20.00
+28.4	-2	-18.89
+32.0	0	-17.78
+35.6	+2	-16.67
+39.2	+4	-15.56
+42.8	+6	-14.44
+46.4	+8	-13.33

to °F	From	to °C
+50.00	+10	-12.22
+53.6	+12	-11.11
+57.2	+14	-10.00
+60.8	+16	-8.89
+64.4	+18	-7.78
+68.0	+20	-6.67
+71.6	+22	-5.56
+75.2	+24	-4.44
+78.8	+26	-3.33
+82.4	+28	-2.22
+86.0	+30	-1.11
+89.6	+32	0.00
+93.2	+34	+1.11
+96.8	+36	+2.22
+100.4	+38	+3.33
+104.0	+40	+4.44
107.6	42	5.56
111.2	44	6.67
114.2	46	7.78
118.4	48	8.89
122.0	50	10.00
125.6	52	11.11
129.2	54	12.22
132.8	56	13.33
136.4	58	14.44
140.0	60	15.56
143.6	62	16.67
147.2	64	17.78
150.8	66	18.89
154.4	68	20.00
158.0	70	21.11

to °F	From	to °C
161.6	72	22.22
165.2	74	23.33
168.8	76	24.44
172.4	78	25.56
176.0	80	26.67
179.6	82	27.78
183.2	84	28.89
186.8	86	30.00
190.4	88	31.11
194.0	90	32.22
197.6	92	33.33
201.2	94	34.44
204.8	96	35.56
208.4	98	36.67
212.0	100	37.78
230.0	110	43.33
248.0	120	48.89
266.0	130	54.44
284.0	140	60.00
302.0	150	65.56
320.0	160	71.11
338.0	170	76.67
356.0	180	82.22
374.0	190	87.78
392.0	200	93.33
410.0	210	98.89
428.0	220	104.44
446.0	230	110.00
464.0	240	115.56
482.0	250	121.11

## **Warranty**

**REGARDLESS OF CAUSE**, if a product you buy from this brochure does not work right, Gast will repair or replace it once, at no charge, for up to one year from the date of shipment from the factory. In the course of repair or replacement, Gast may send you written recommendations on how to prevent a problem from happening again. Gast reserves the right to withdraw this warranty if you do not follow these recommendations. Customer is responsible for freight charges both to and from Gast in all cases. This warranty does not apply to electric motors, electrical controls, and gasoline engines, which Gast obtains from other manufacturers. A motor or engine carries only the warranty of the company that makes it.

THIS WARRANTY IS EXCLUSIVE AND IS IN LIEU OF ALL OTHER WARRANTIES, WHETHER WRITTEN, ORAL OR IMPLIED, INCLUDING THE WARRANTY OF MERCHANTABILITY AND OF FITNESS FOR ANY PARTICULAR PURPOSE. GAST'S LIABILITY IS IN ALL CASES LIMITED TO THE REPLACEMENT PRICE OF ITS PRODUCT. GAST SHALL NOT BE LIABLE FOR ANY OTHER DAMAGES, WHETHER CONSEQUENTIAL, INDIRECT, OR INCIDENTAL, ARISING FROM THE SALE OR USE OF ITS PRODUCTS.

Gast's sales personnel may modify this warranty, but only by signing a specific, written description of any modifications.

## **DISCLAIMER**

The information presented in this catalog is based on technical data and test results of nominal units. It is believed to be accurate and is offered as an aid in the selection of Gast products. It is the user's responsibility to determine suitability of the product for his intended use and the user assumes all risk and liability whatsoever in connection therewith.

**APPENDIX C**

**DATA COLLECTION SHEETS**

**DATA COLLECTION SHEET  
BLOWER SYSTEM #1 (VW2-VWE  
SITE SS-41  
CHARLESTON AFB, SOUTH CAROLINA**

**DATA COLLECTION SHEET  
BLOWER SYSTEM #1 (VW2-VW  
SITE SS-41  
CHARLESTON AFB: SOUTH CARO**

BLOWER#1.XLS

**CHARLESTON AFB, SOUTH CAROLINA**

**DATA COLLECTION SHEET**

**BLOWER SYSTEM #1 (VW2-VW6)**

**SITE SS-41**

BLOWER#1.XLS

**DATA COLLECTION SHEET  
BLOWER SYSTEM #1 (VW2-VWE  
SITE SS-41  
CHARLESTON AFB, SOUTH CAROLINA**

BLOWER#1.XLS

**DATA COLLECTION SHEET  
BLOWER SYSTEM #2 (VW7-VW12)**

**CHARLESTON AFB, SOUTH CAROLINA**

**DATA COLLECTION SHEET  
BLOWER SYSTEM #2 (VW7-VW12)  
SITE SS-41  
CHARLESTON AFB, SOUTH CAROLINA**

BLLOWER#2.XLS

**CHARLESTON AFB, SOUTH CAROLINA**

**DATA COLLECTION SHEET**

**BLOWER SYSTEM #2 (VW7-VW12)**

**SITE SS-41**

**CHARLESTON AFB. SOUTH CAROLINA**

**DATA COLLECTION SHEET**

**BLOWER SYSTEM #2 (VW7-VW12)**

**SITE SS-41**